


T.36 S.R.1&2 W.W.M.

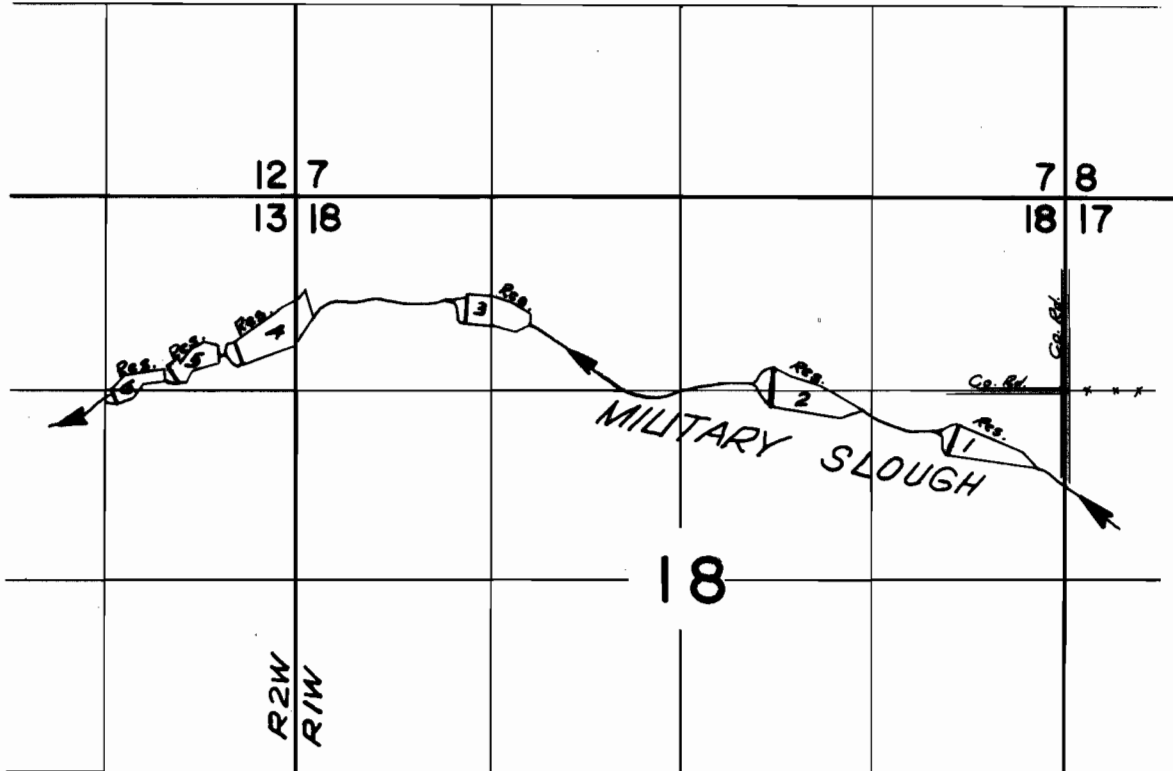

FINAL PROOF SURVEY
UNDER

Application No. R-37596 Permit No. R-3269
IN NAME OF
OREGON STATE GAME COMMISSION

Surveyed JUNE 10 1968, by V. GARNER