


T.36 S.R.1&2 W.W.M.

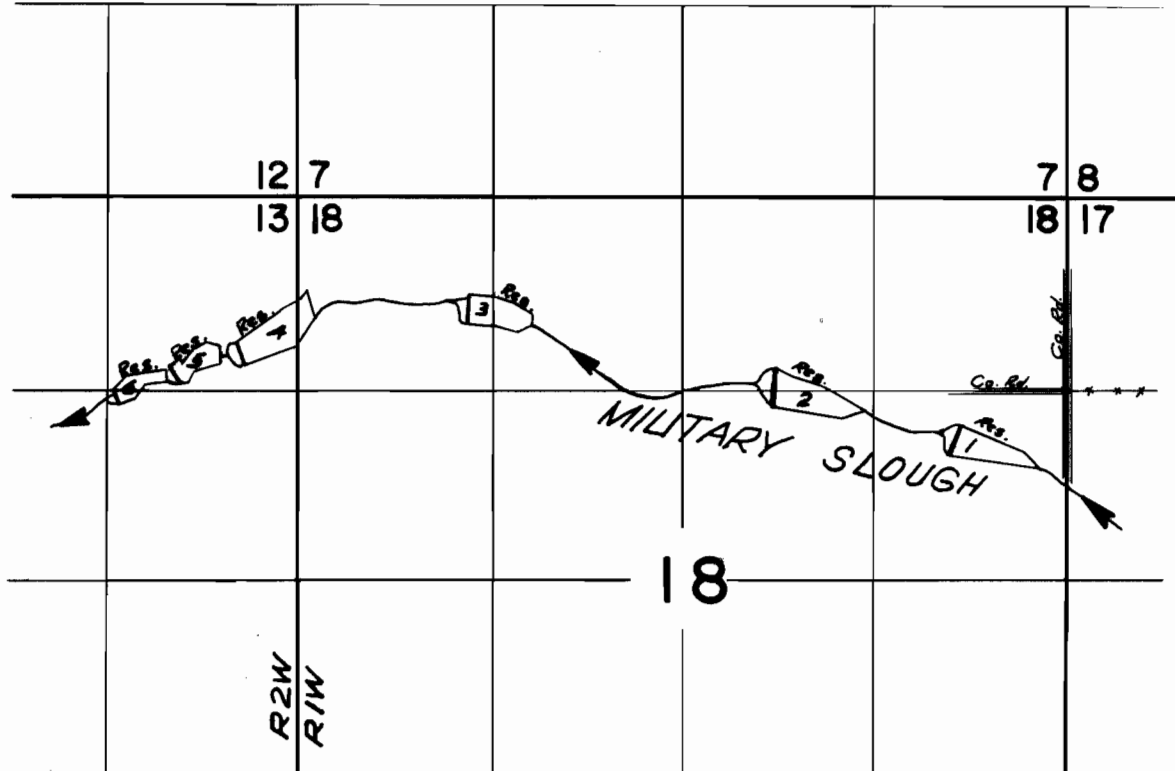

FINAL PROOF SURVEY UNDER

Application No. *R-37596* Permit No. *R-3269*
IN NAME OF
OREGON STATE GAME COMMISSION

Surveyed *JUNE 10, 1968*, by *V. GARNER*