


T.9S. R.15E.W.M.

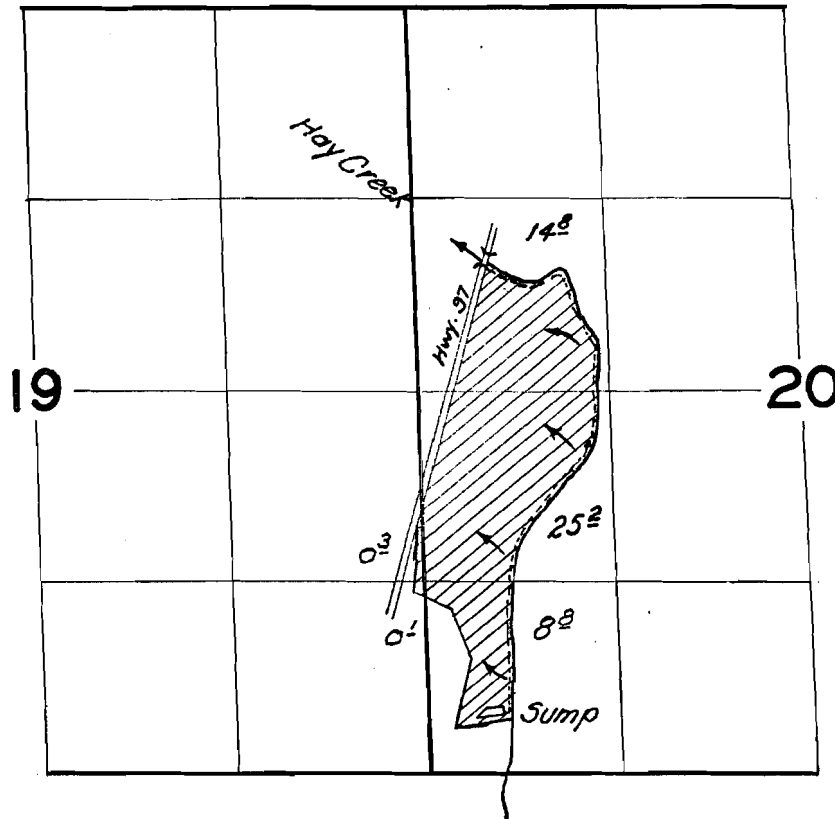

FINAL PROOF SURVEY  
UNDER

Application No. G-1407 Permit No. G-1297  
IN NAME OF

Henry W. Lever

Surveyed Oct. 31, 1962, by Ralph Jackson