


G-1486

30964

T.9S. R.15E.W.M.

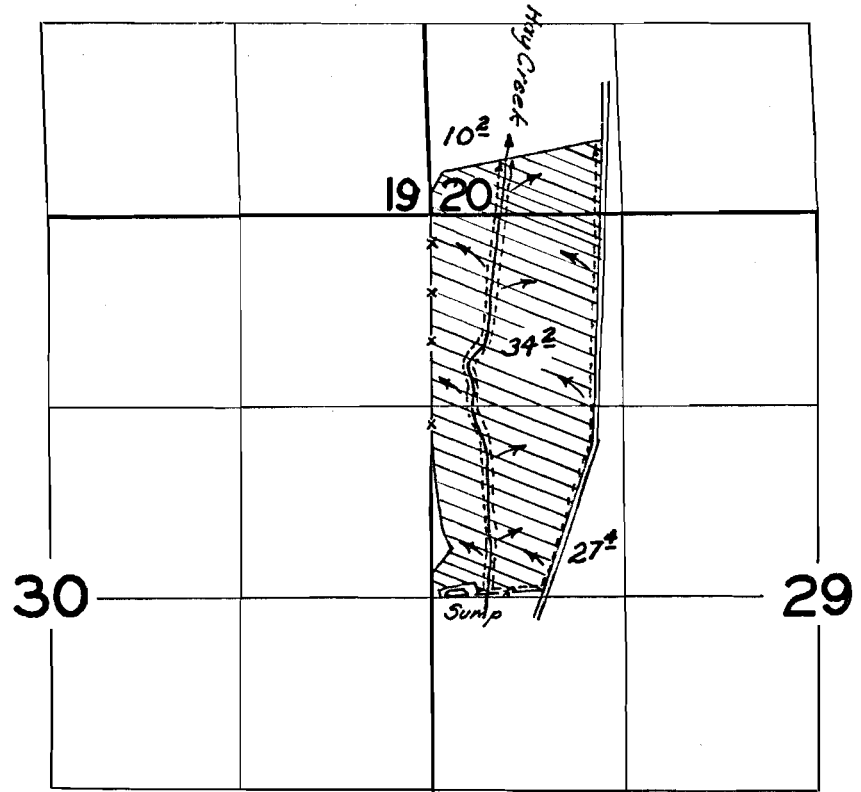

FINAL PROOF SURVEY UNDER

Application No. G-1618... Permit No. G-1486.
IN NAME OF

.....*J. Lester Horigan*.....

Surveyed *Oct. 31*.. 1962., by *Ralph Jackson*

G-1486
3/1962-0