


RECEIVED
APR 22 1963
STATE ENGINEER
SALEM, OREGON

TWP 36 S R 7 W W M

NW 1/4 Sec. 14

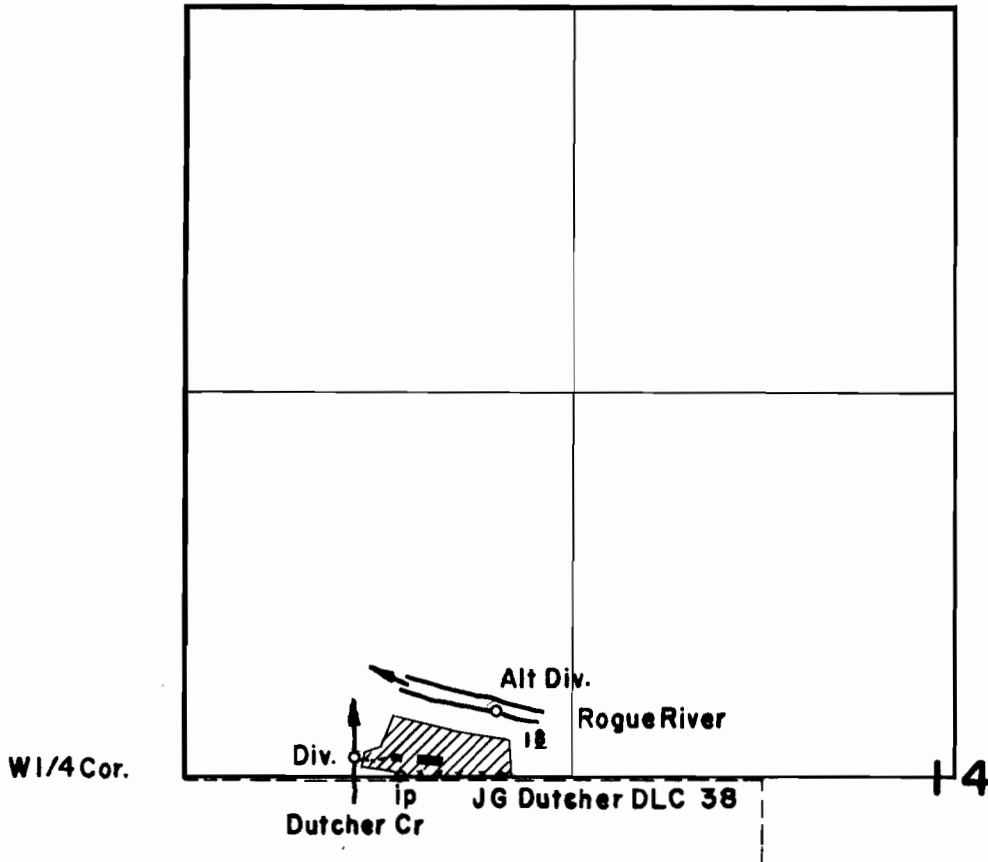

FINAL PROOF SURVEY
UNDER

Application No. 34972... Permit No. 27427...
IN NAME OF

... EB or Evelyn E. Bennett ...

Surveyed 6-4 1962, by R. Steimer
Scale 8" = 1 Mi