


27145
30971
45138

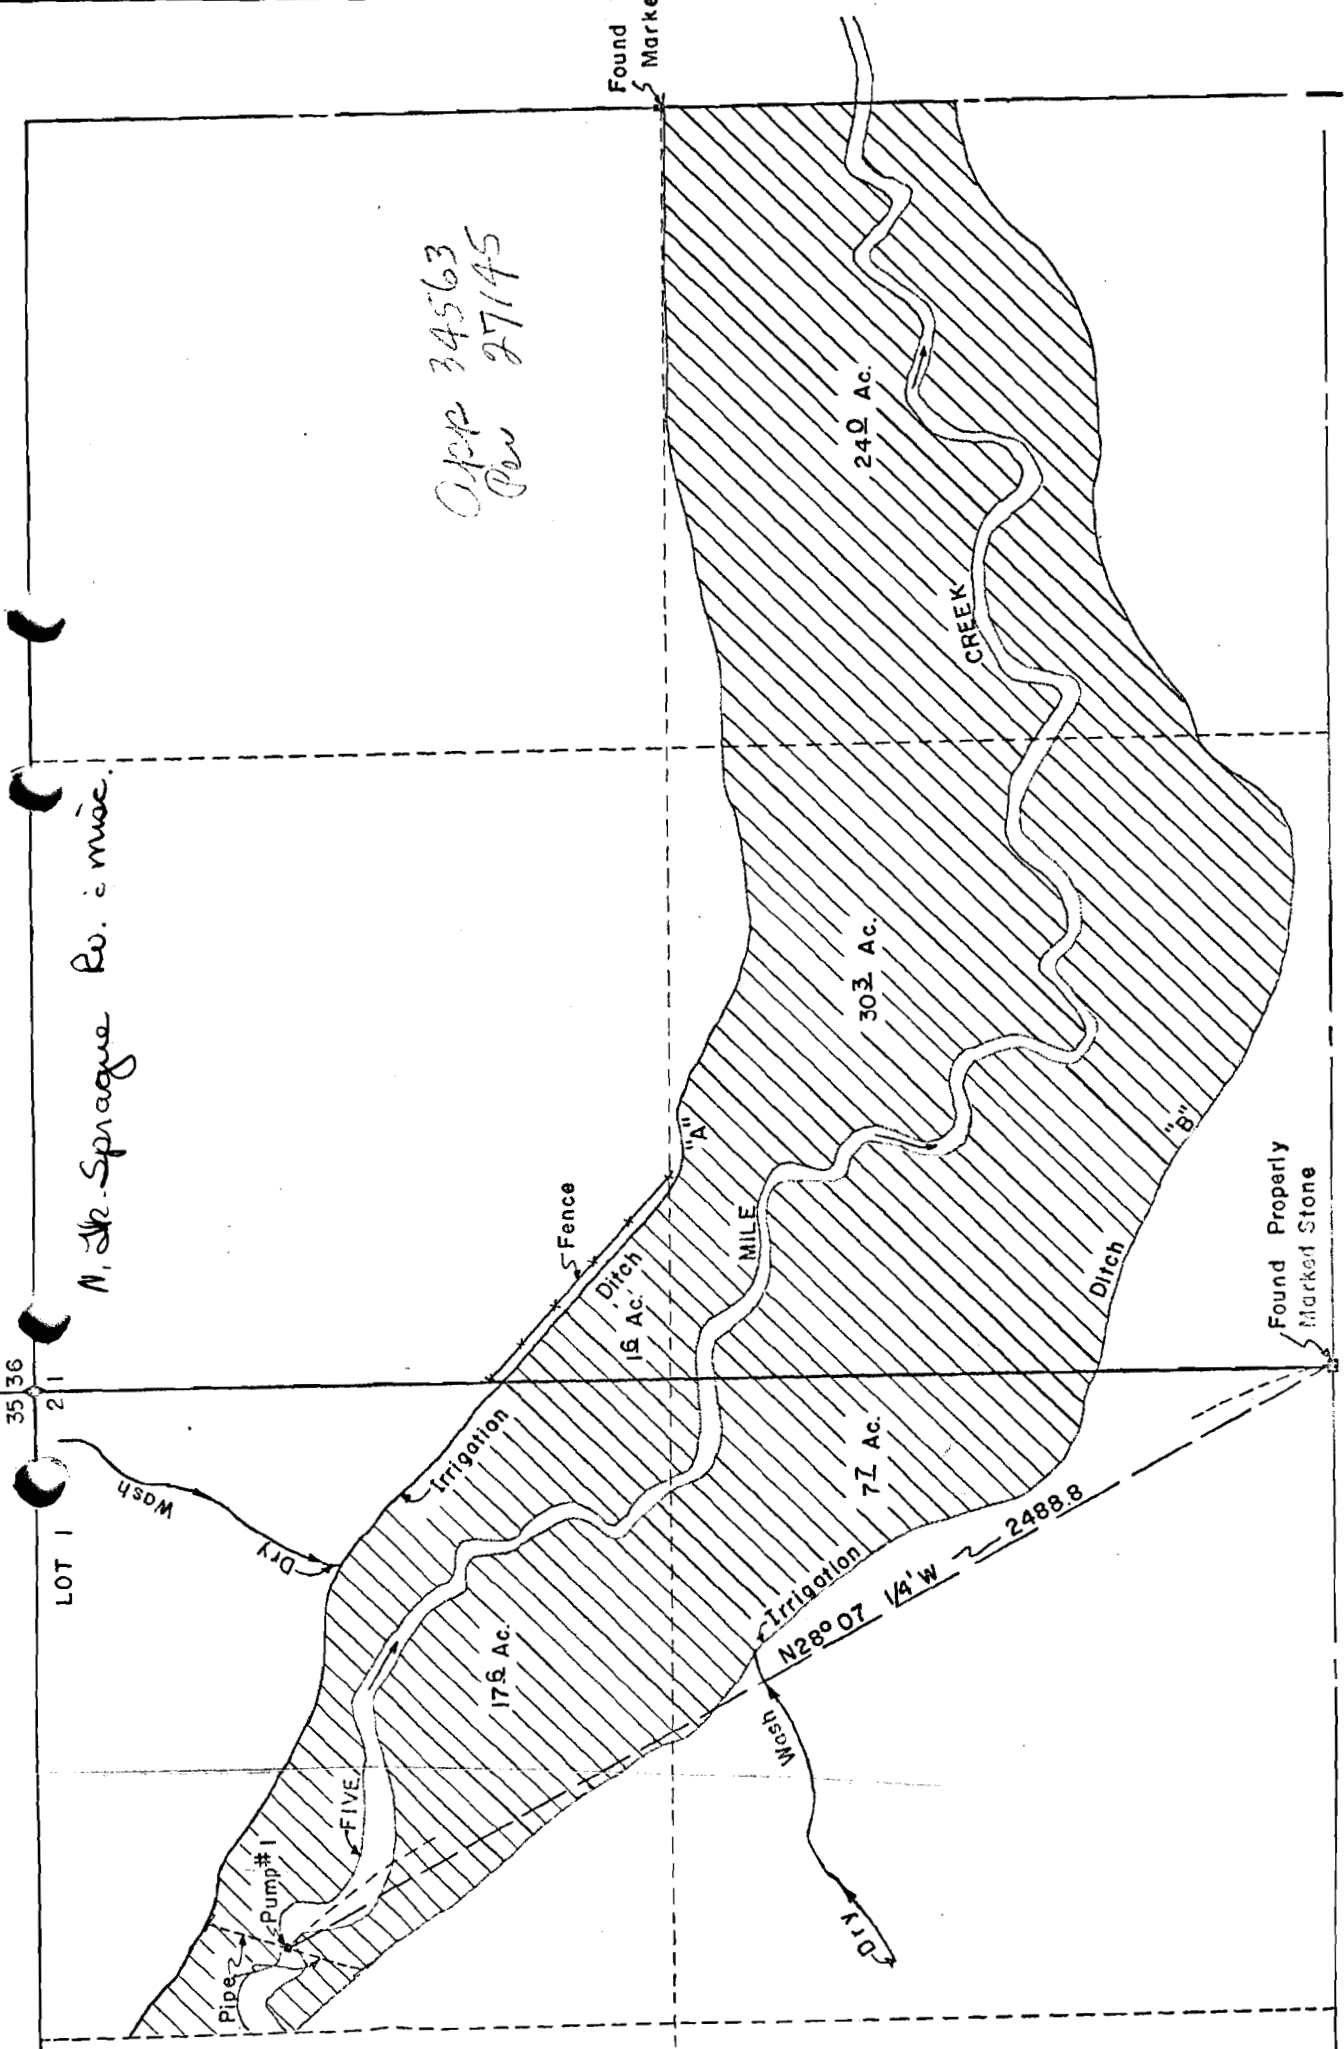

Opp 34563
Per 27145

N. Sprague Riv. & mac.

LOT 1
35 36
21

SECTIONS 1 & 2 T36S., R13E., W.M