


P. 27312
30974

T.40S. R.19E. W.M.

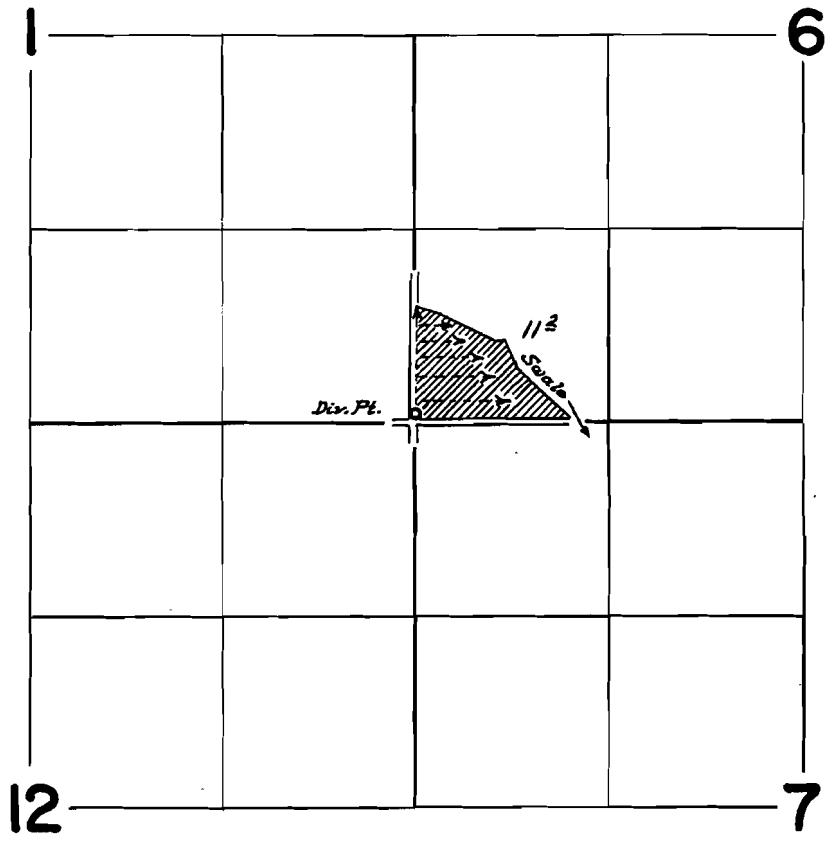

FINAL PROOF SURVEY UNDER

Application No. 33983 Permit No. 27312
IN NAME OF

Thomas Goss

Surveyed Sept. 14, 1962, by Thomas R. Lauer