


T. 20S. R. 4W.W. M. .

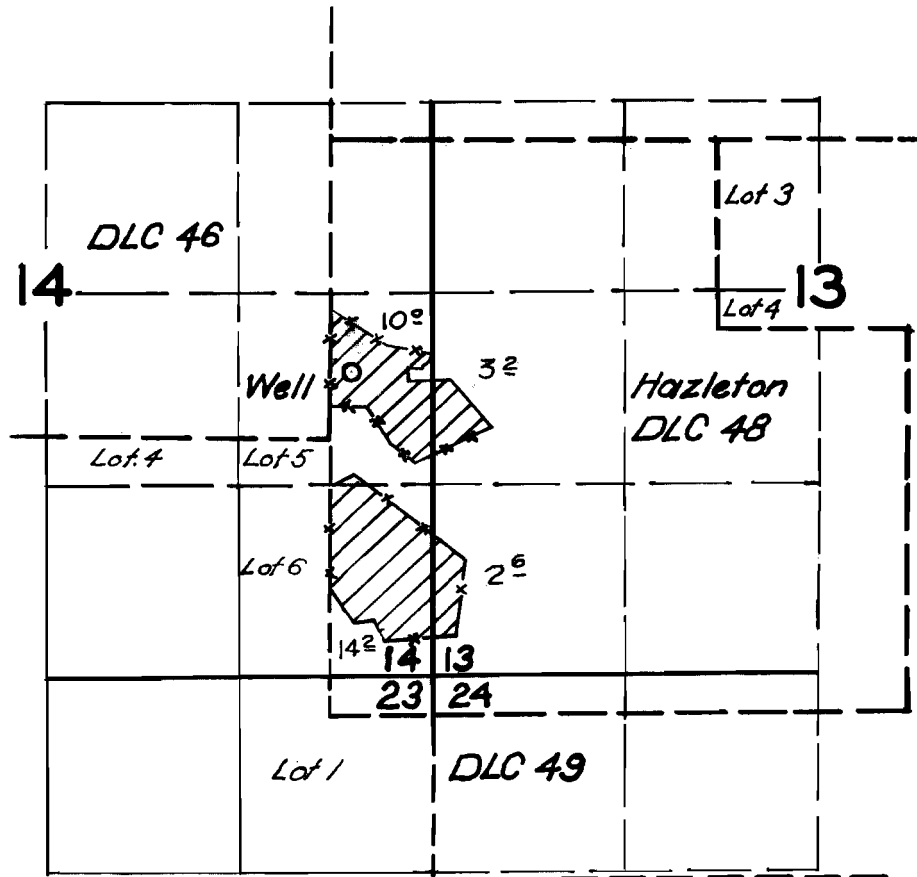

FINAL PROOF SURVEY
UNDER

Application No. G-661 Permit No. G-640
IN NAME OF

Ross Overholser

Surveyed May 7 1962, by Carl R. Baker