


T.17S.R.1W.W.M.

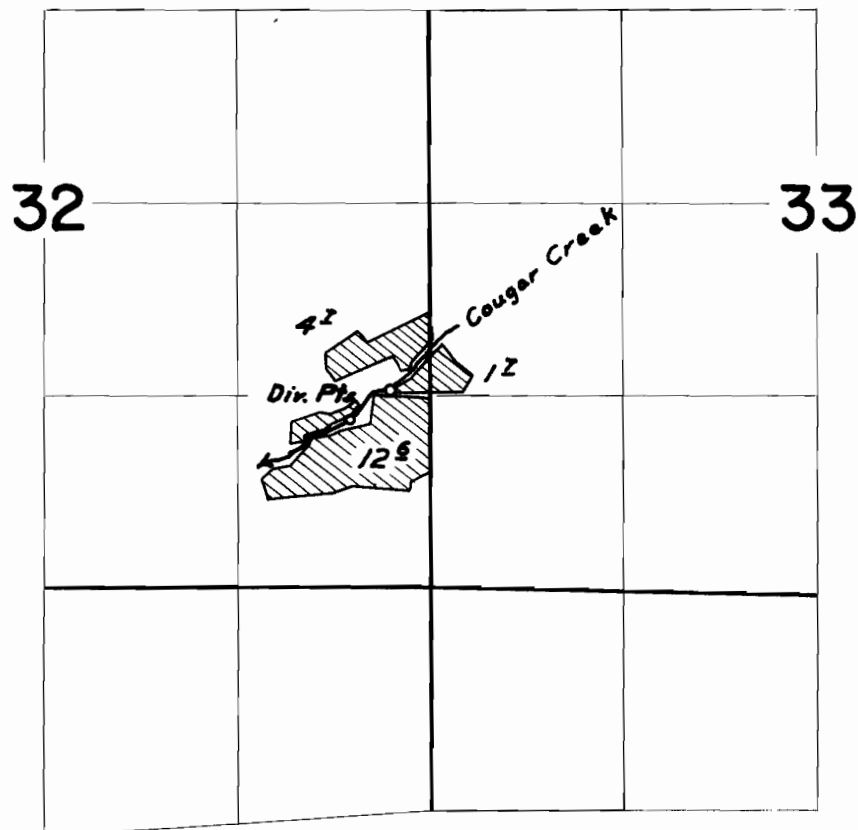

FINAL PROOF SURVEY
UNDER

Application No. 31537 Permit No. 24873
IN NAME OF

Robert G. Kintigh

Surveyed May 24 1962, by *Thomas R. Lauer*