


T.20S. R. 4W.W.M.

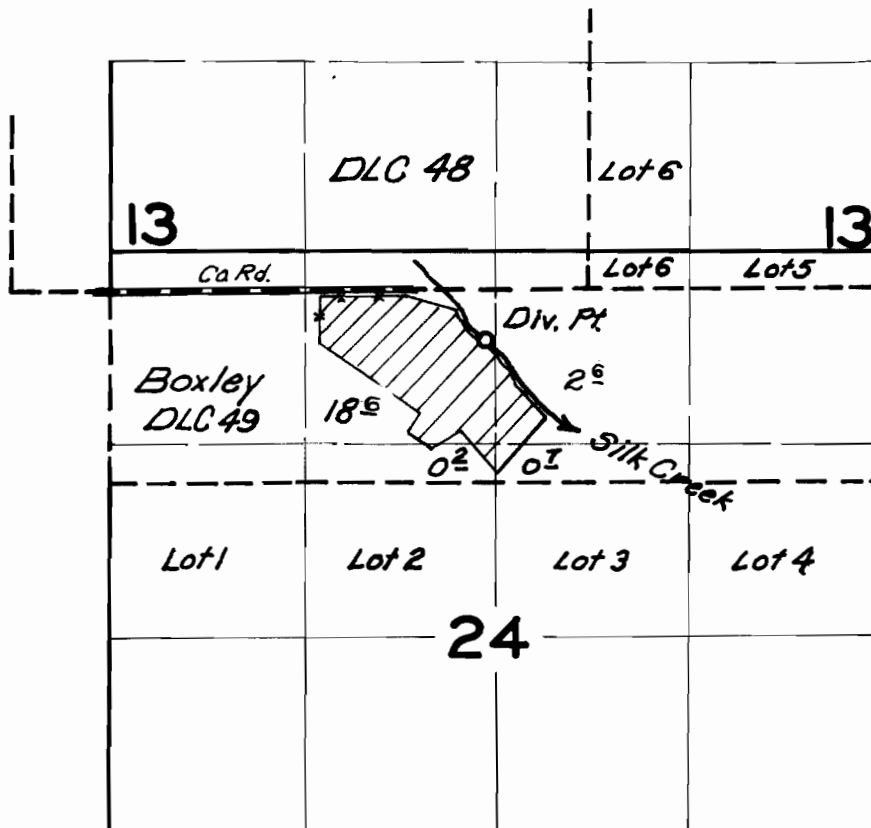

FINAL PROOF SURVEY
UNDER

Application No. 31691 Permit No. 24995
IN NAME OF

S. Leslie Godard & Ruby Godard

Surveyed 10 Jan. 1963, by Carl R. Baker