


T.17 S. R.1 W. W.M.

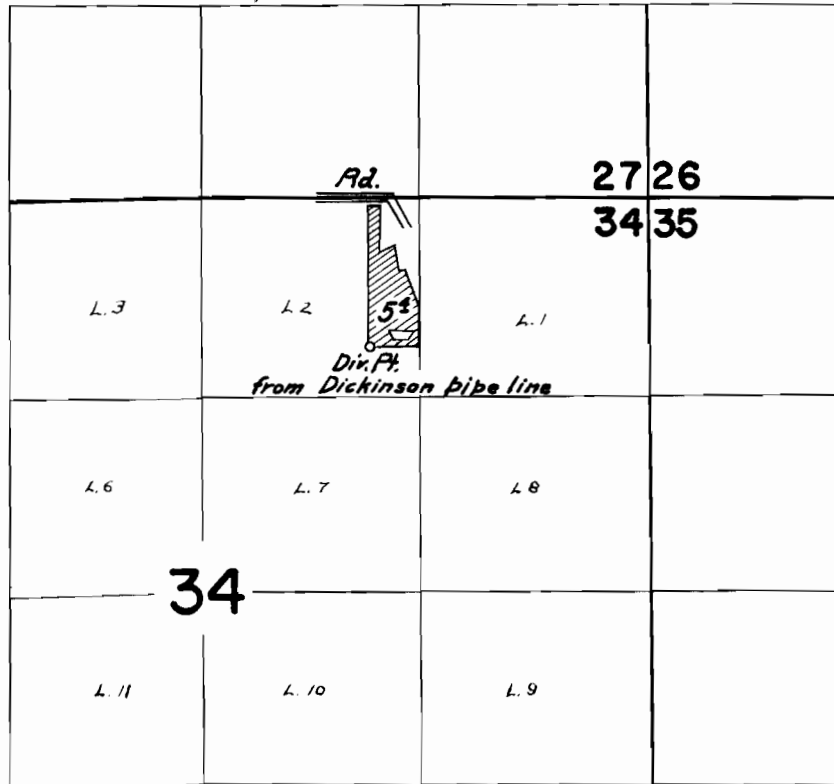

FINAL PROOF SURVEY
UNDER

Application No. 32227 Permit No. 25425
IN NAME OF

M. E. Kirkpatrick

Surveyed May 11, 1962, by Thomas R. Lauer