


T.18S. R.1&2 W.W.M.

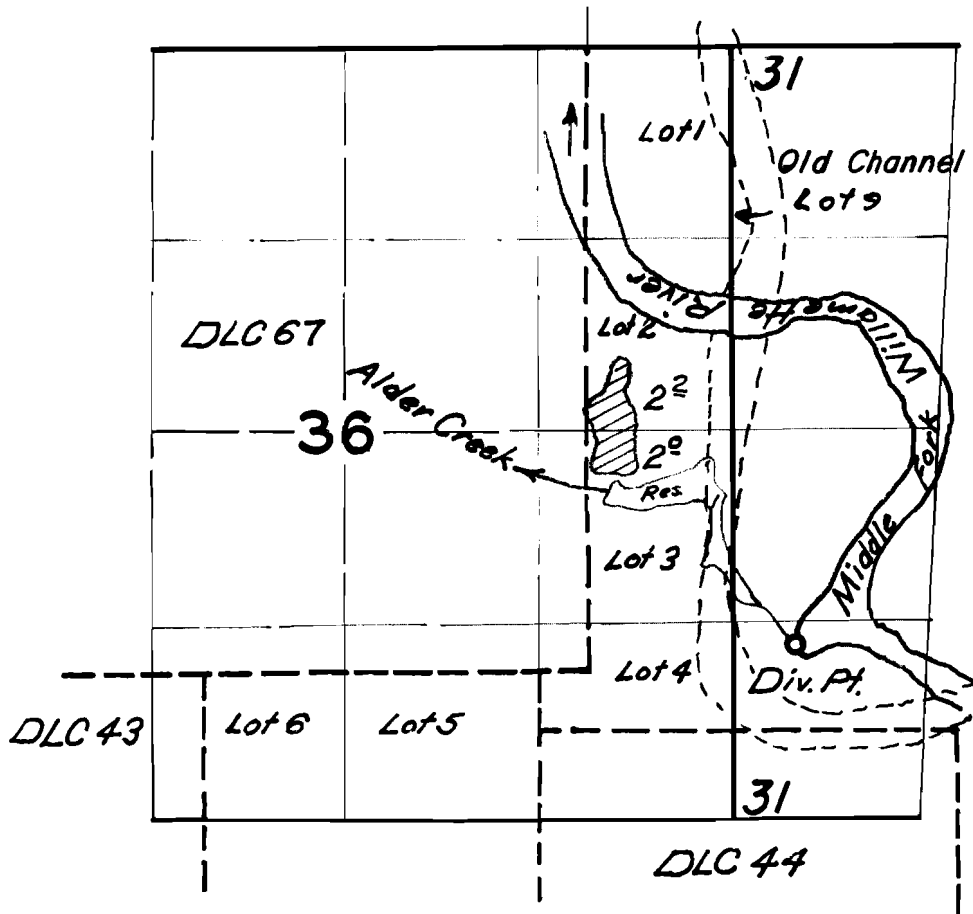

FINAL PROOF SURVEY
UNDER

Application No. *R-32921* *R-2220*
32922 Permit No. *25983*
IN NAME OF

Paul D. Green

Surveyed *11 May* 1962, by *Carl R. Baker*