


T. 20S. R. 3W.W.M.

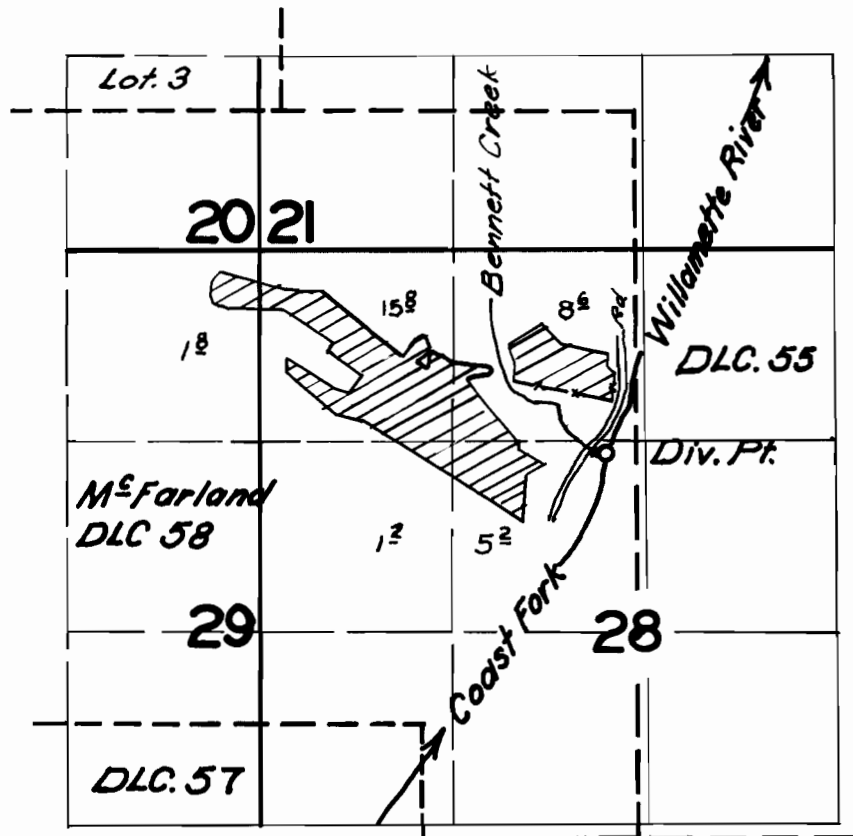

FINAL PROOF SURVEY
UNDER

Application No. 33568 Permit No. 26558
IN NAME OF

Patricia A. Daugherty

Surveyed 24 May 1962, by Carl R. Baker