


T. 20S. R. 1W. W.M.

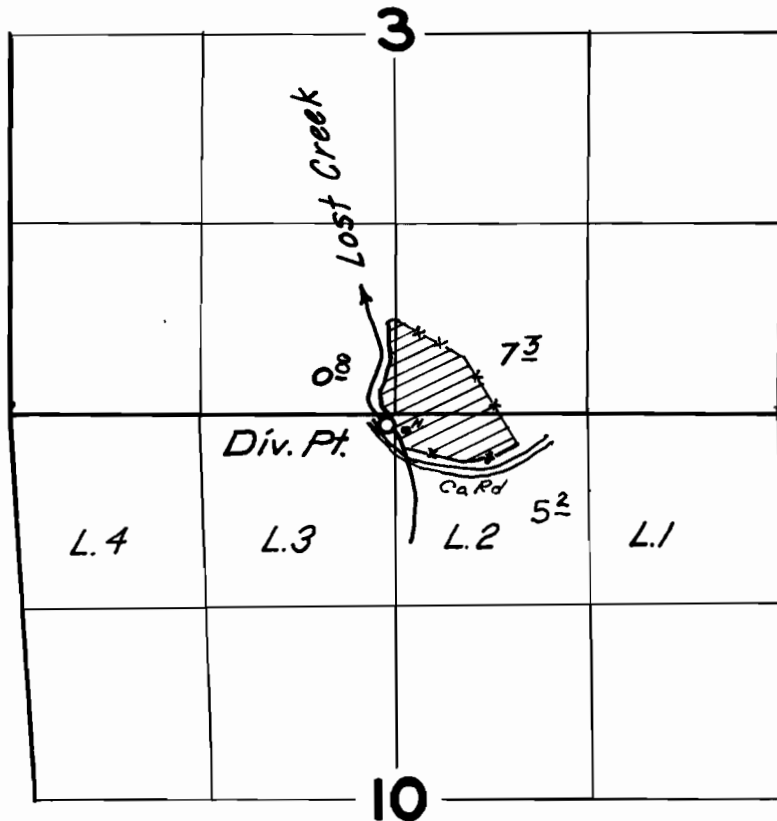

FINAL PROOF SURVEY
UNDER

Application No. 34495 Permit No. 27102
IN NAME OF

Roy C. & Doris Maye Bradley - Harold Hooker

Surveyed 21 May, 1962, by Carl R. Baker