


T. 9 S. R. 3 E.W.M.

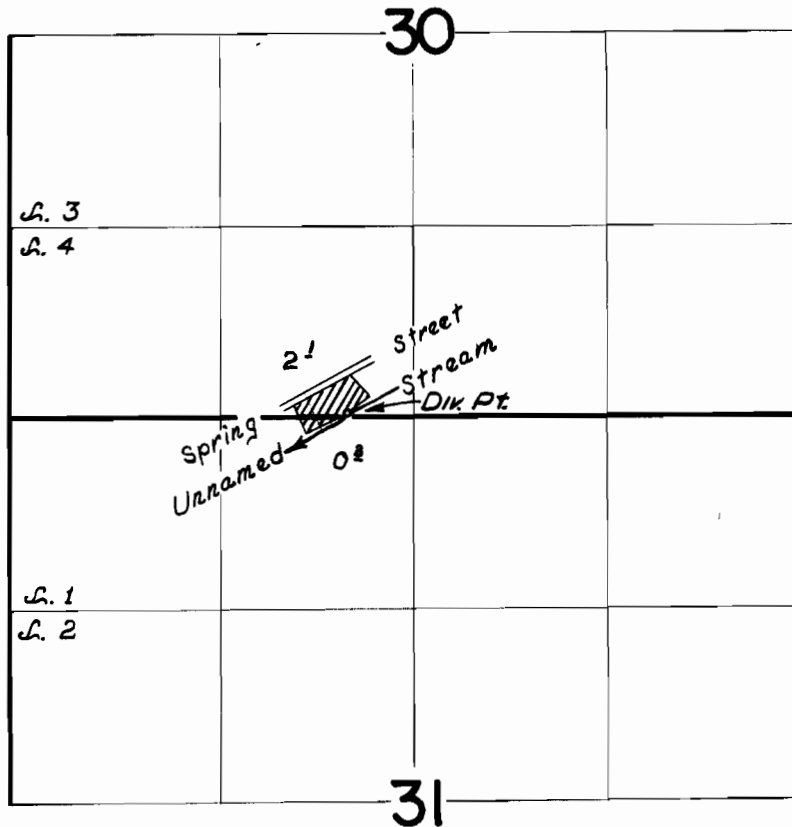

FINAL PROOF SURVEY UNDER

Application No. 32516 Permit No. 25687
IN NAME OF

THELMA M. MOORE

Surveyed April 2 1962, by T.R. Lauer