


# T.19S.R.44E.W.M.

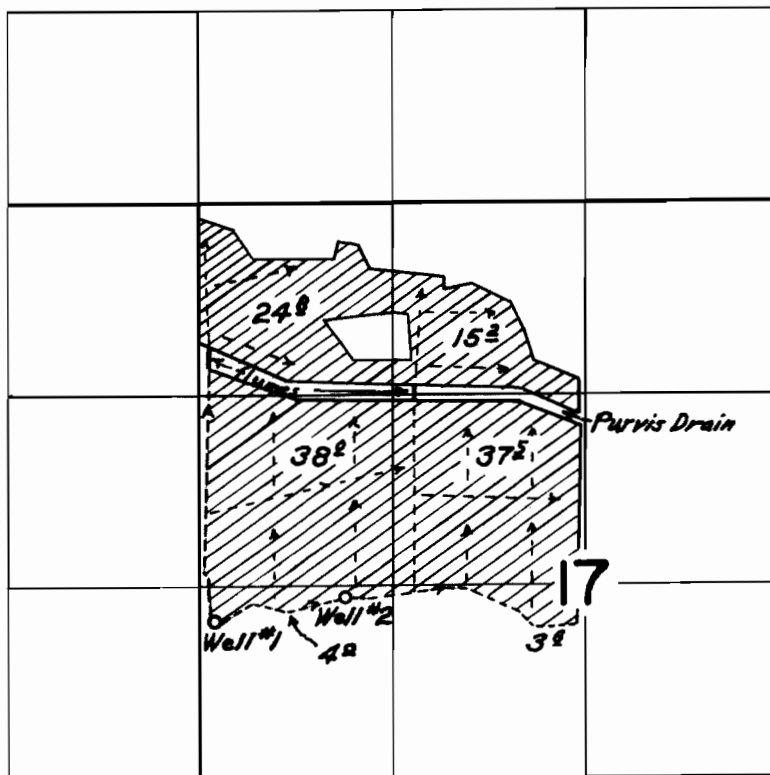

## FINAL PROOF SURVEY UNDER

Application No. 6-90 Permit No. 6-46  
IN NAME OF

Anna Mary Robbins

Surveyed June 6, 1962, by Thomas R. Lauer