


T. 13 & 14 S. R. 41 E. W. M.

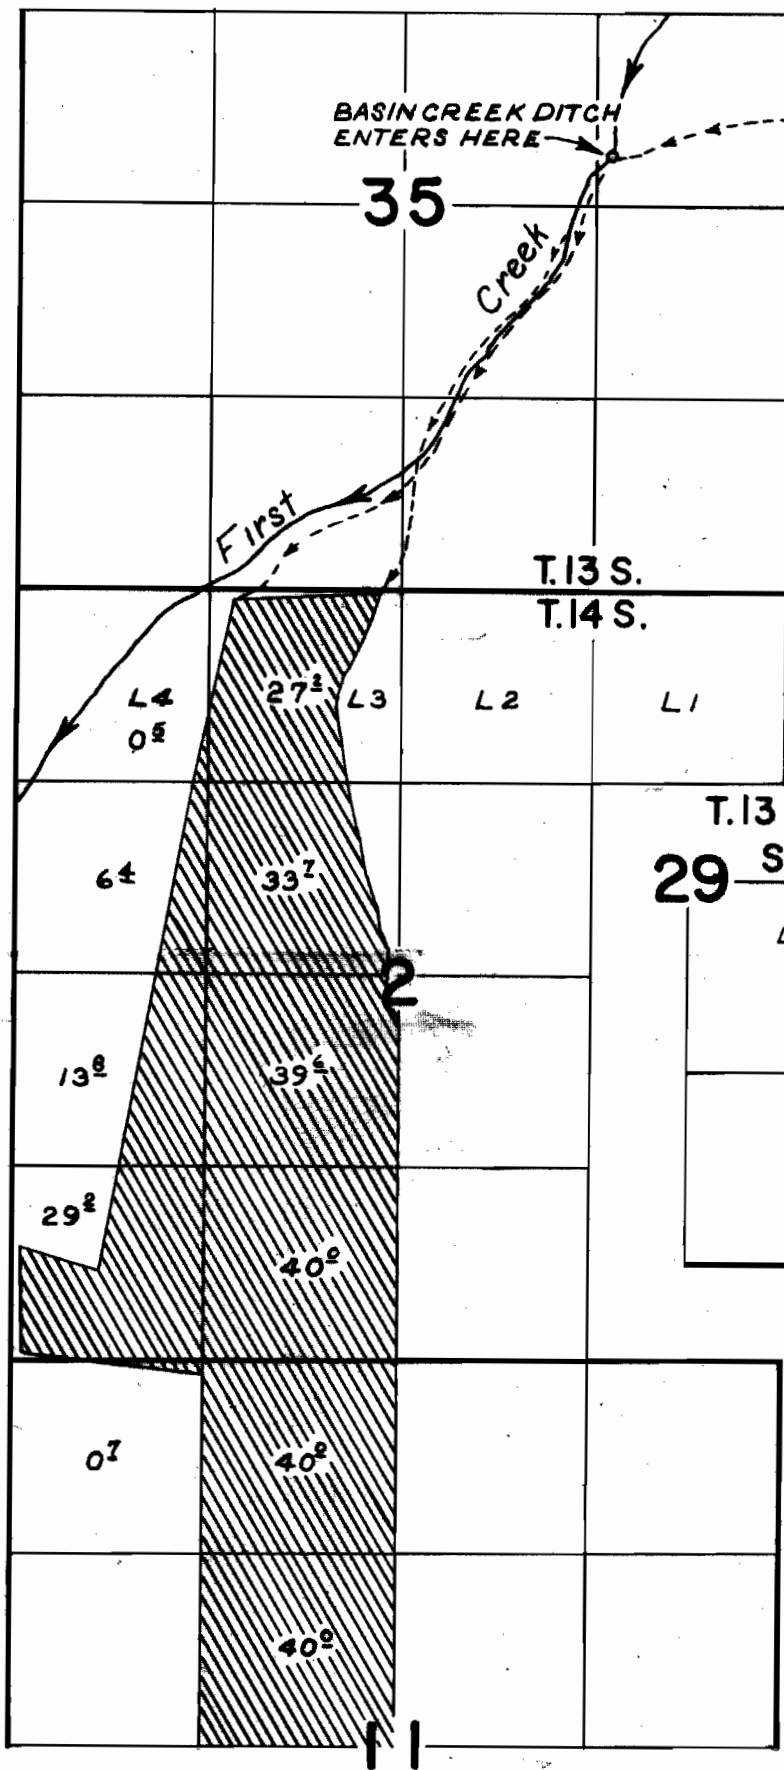

FINAL PROOF SURVEY

Application No.31219 Permit No.24608
IN NAME OF
FRANCIS DOMBY

Surveyed June 13 1962, by C.R. Baker

*Diversion point
location taken from
application map.*

BBC-19N-117