


T. 19 S.R. 47 E.W.M.

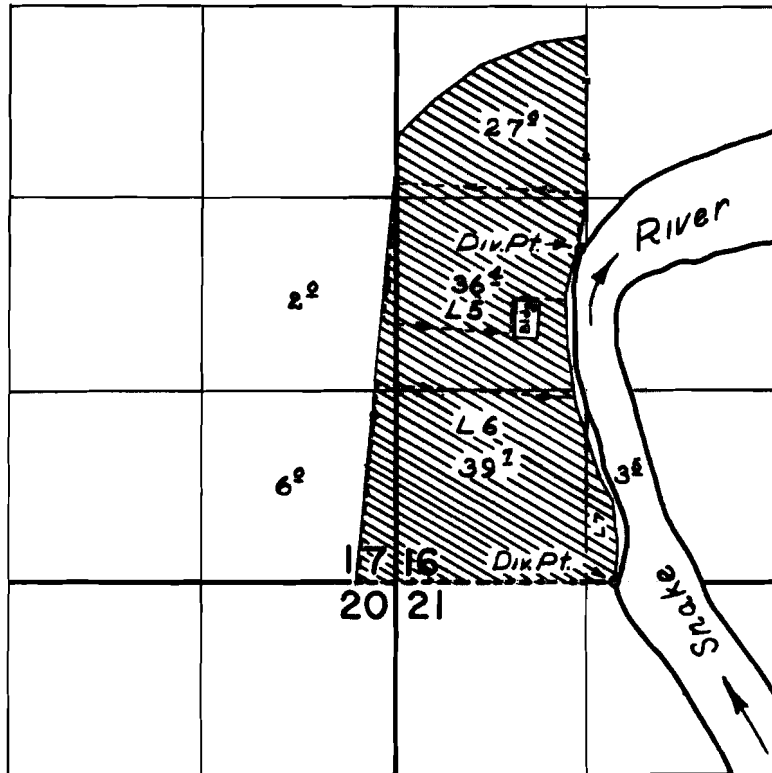

FINAL PROOF SURVEY UNDER

Application No. 33565... Permit No. 26535...
IN NAME OF

..... **DWIGHT SEWARD**

Surveyed *July 10, 1962*, by *C.R. Baker*.....