


T.9S.R.4E.W.M.

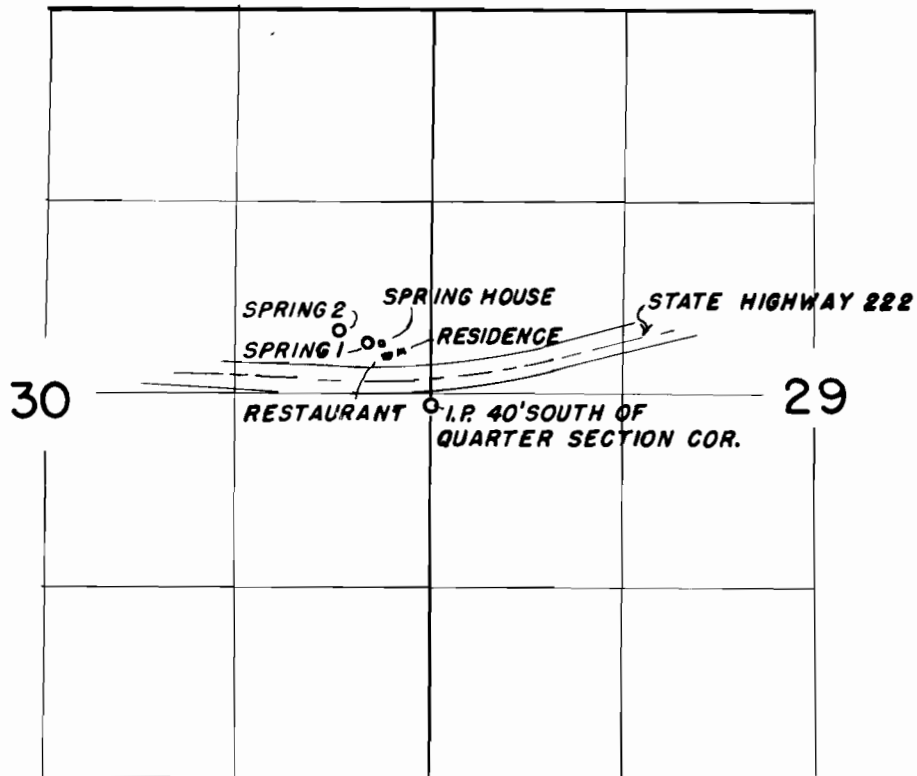

FINAL PROOF SURVEY
UNDER

Application No. 30936 Permit No. 24414
IN NAME OF

LILYAN M. GRIGSBY

Surveyed Sept. 24 1962, by *Floyd L. Siegmund*