


T. IN. R. 3 E. W. M.

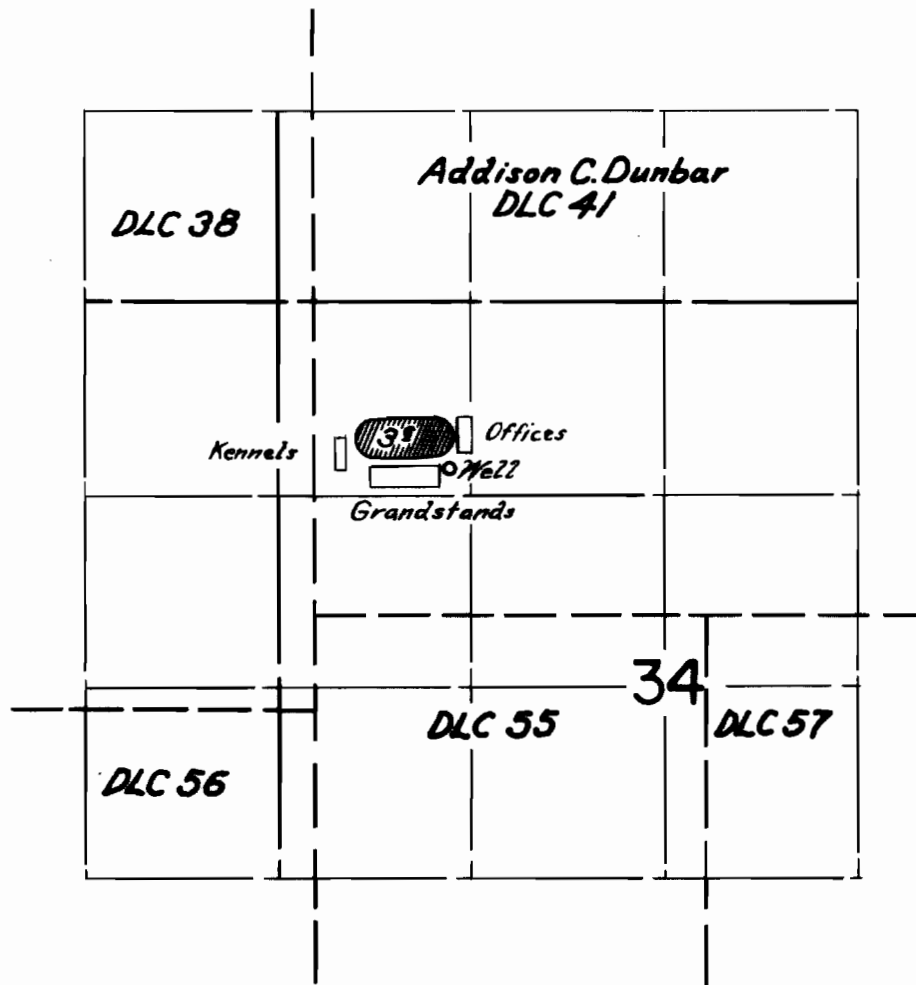

FINAL PROOF SURVEY UNDER

Application No. G-246 Permit No. G-1316
IN NAME OF

Multnomah Kennel Club

Surveyed June 29 1962, by Thomas R. Lauer