


T.I.S.R.3E.W.M.

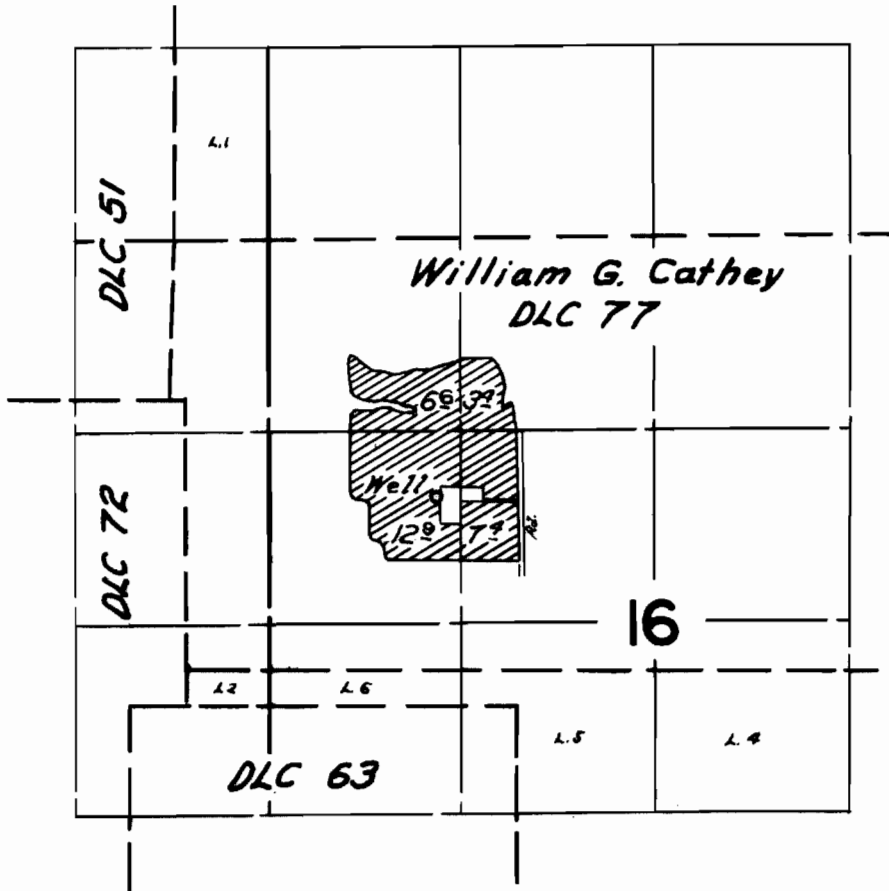

FINAL PROOF SURVEY UNDER

Application No. *G-1546* Permit No. *G-1415*
IN NAME OF

Kazuo + Ami D. Kinoshita

Surveyed *June 22, 1962*, by *Thomas F. Lauer*