


T.7S. R.5W.W.M.

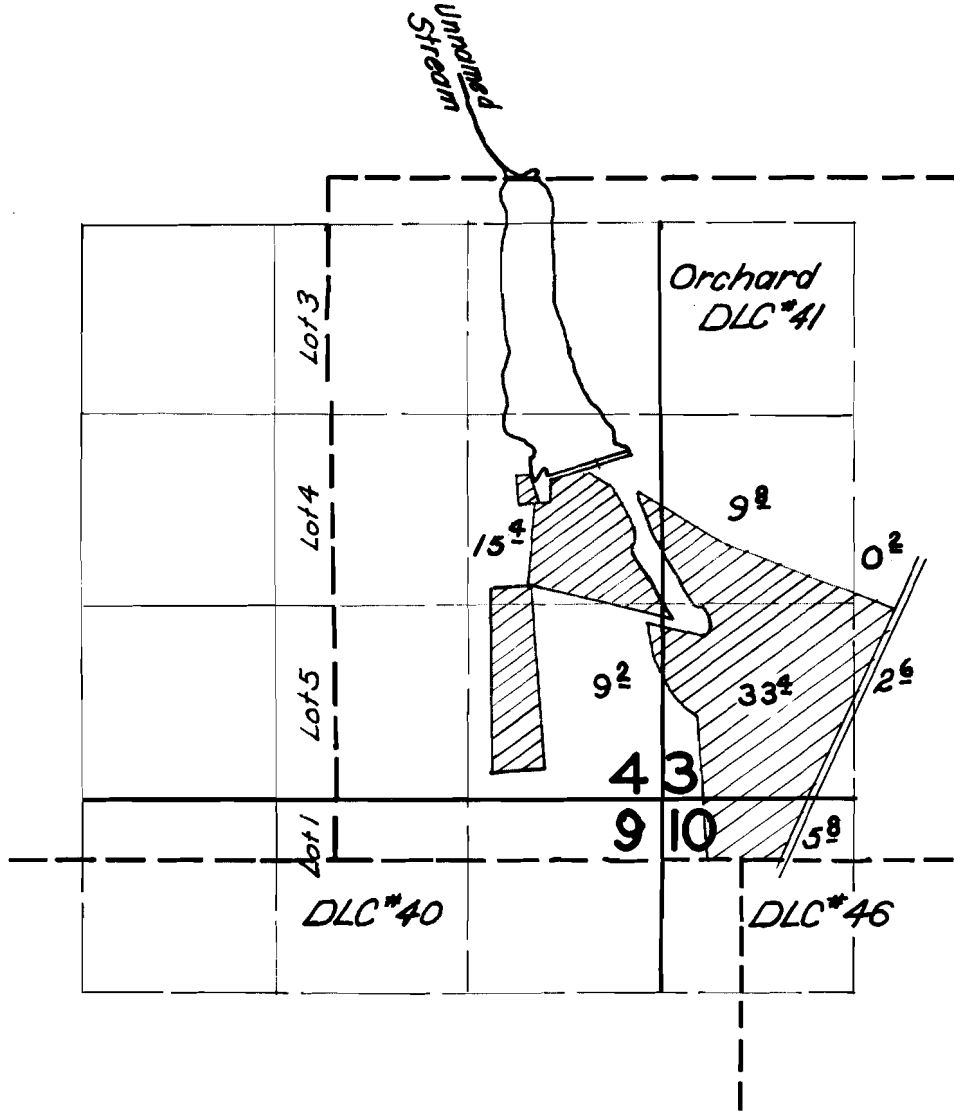

FINAL PROOF SURVEY
UNDER

R-32373 *R-2147*
Application No. *32374* Permit No. *25533*
IN NAME OF

William Reimer

Surveyed *July 5* 1962, by *Carl R. Baker*