


T.7S. R.6W.W.M.

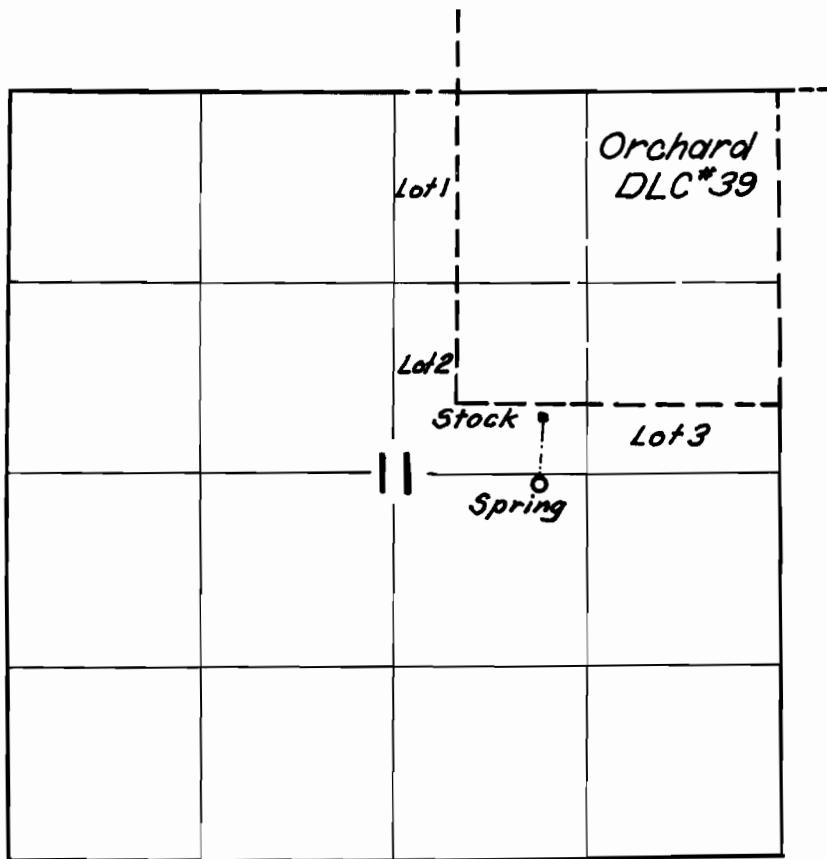

FINAL PROOF SURVEY
UNDER

Application No. *34626*. Permit No. *27202*.
IN NAME OF

Charles G. Wright

Surveyed *27 August 1962*, by *Carl R. Baker*