


T. 1 S. R. 17 E. W. M.

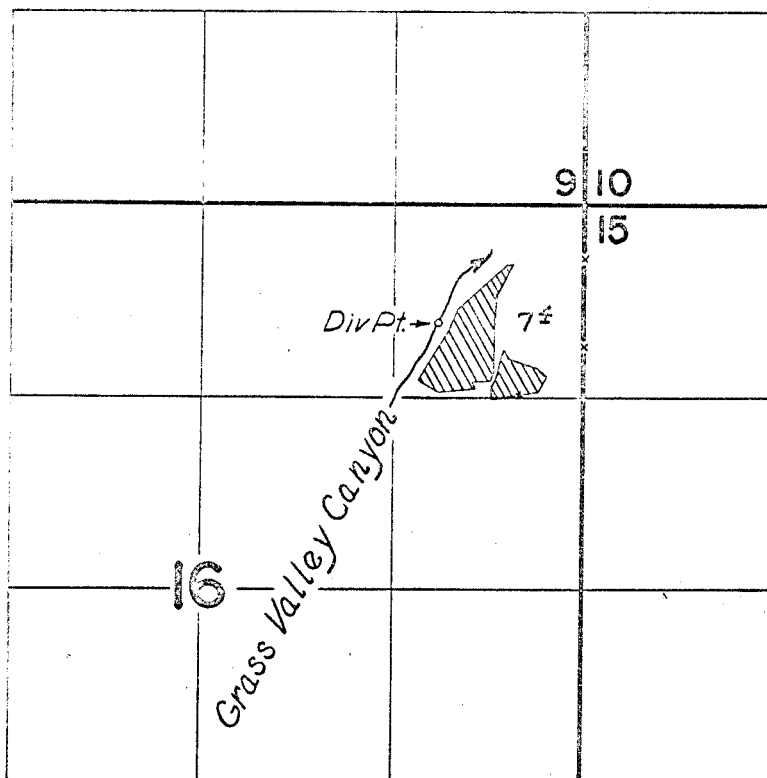

FINAL PROOF SURVEY
UNDER

Application No. 32396..... Permit No. 25581.....
IN NAME OF

.....AURELIUS DOUMA.....

Surveyed Sept. 29, 1962, by C. R. Baker.....