


U-155

# T. 1 N. R. 13 E. W.M.

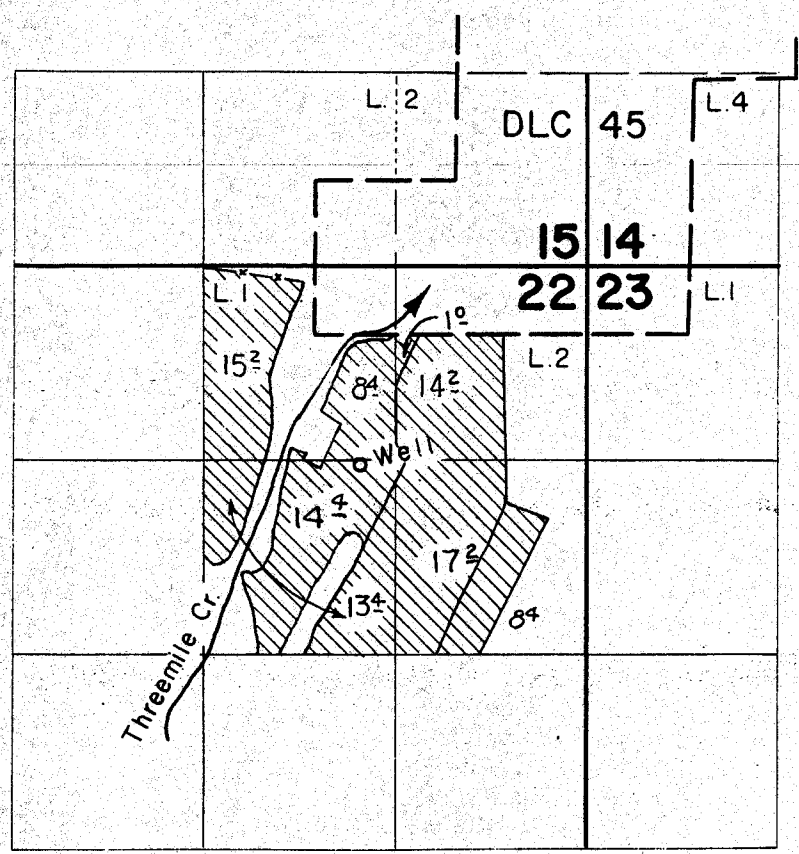

## FINAL PROOF SURVEY UNDER

Application No. U-163    Permit No. U-155  
IN NAME OF

**RICHARD RENKEN & SONS**

Surveyed May. 10. 1962, by *L. W. Jelousch*