


25482  
R2129

# T. I S. R. 12 E. W. M.

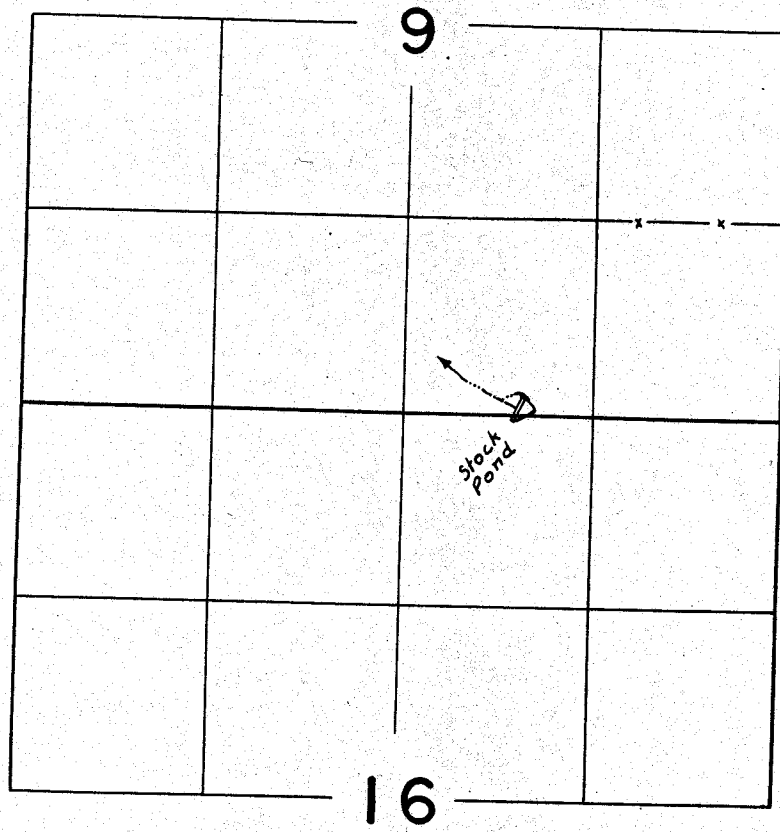

## FINAL PROOF SURVEY UNDER

R-32271                      R-2129  
Application No. 32272    Permit No. 25482  
IN NAME OF

**JESSE P. MILLER**

Surveyed June 13 1962, by *L. W. Johnson*