


25482
R2129

T. I S. R. 12 E. W. M.

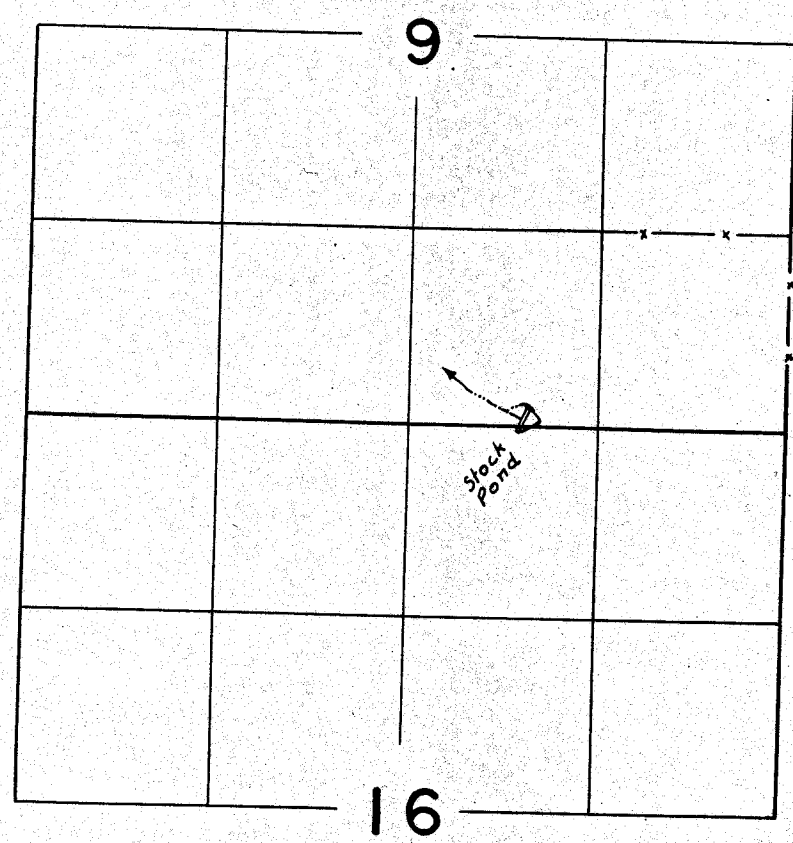

FINAL PROOF SURVEY UNDER

R-32271 R-2129
Application No. 32272 Permit No. 25482
IN NAME OF

JESSE P. MILLER

Surveyed June 13 1962, by *D. W. Johnson*