


25483  
R2130

T. 1 S. R. 12 E. W.M.

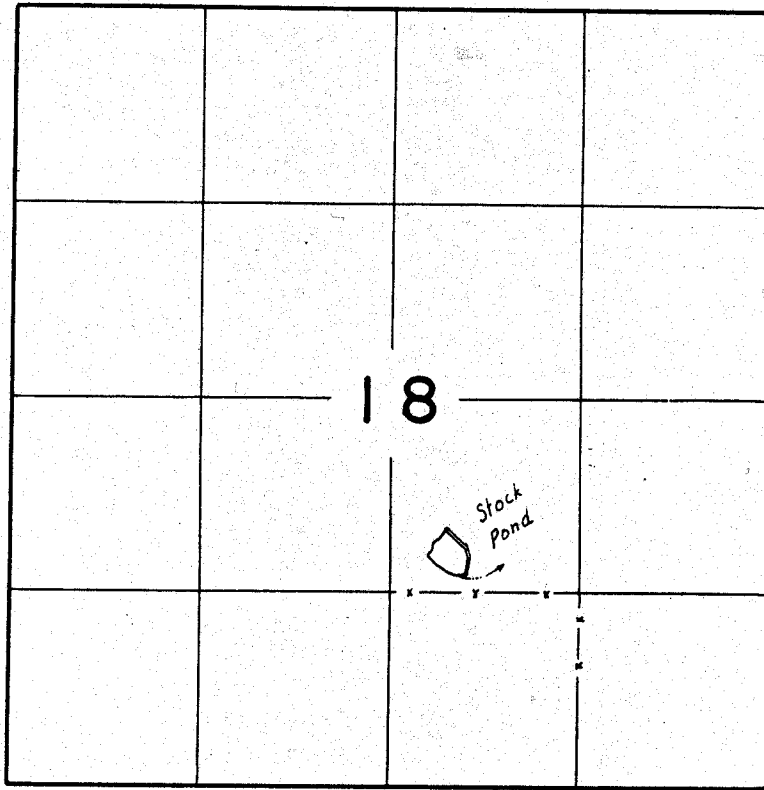

**FINAL PROOF SURVEY**  
UNDER

R-32273

R-2130

Application No. 32274 Permit No. 25483

IN NAME OF

JESSE P. MILLER

Surveyed June 13, 1962, by *L.W. Jelousak*

Dist 3-1962-B