


25483
R2130

T. 1 S. R. 12 E. W.M.

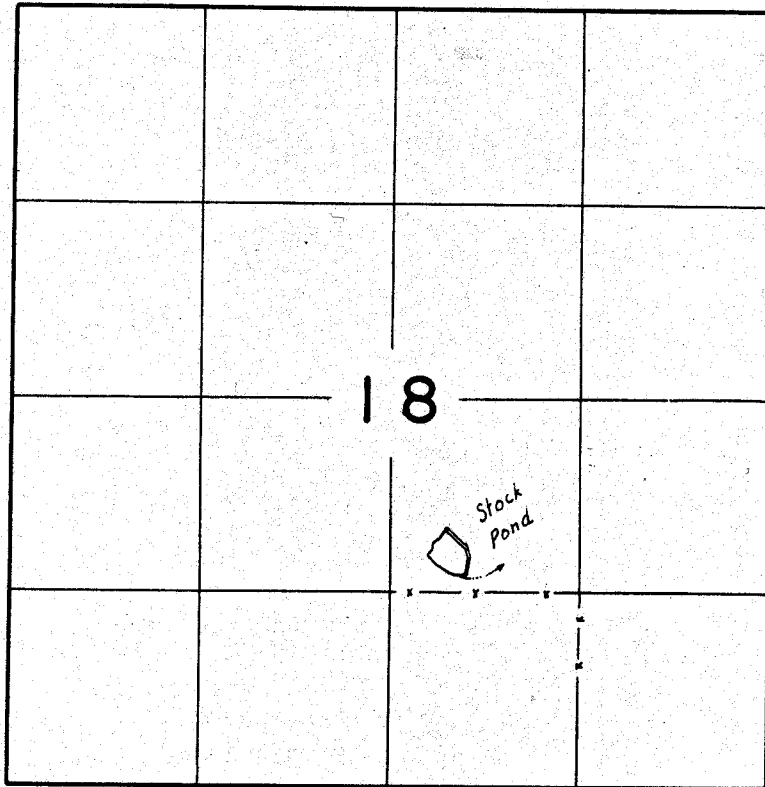

FINAL PROOF SURVEY UNDER

R-32273

R-2130

Application No. 32274 Permit No. 25483

IN NAME OF

JESSE P. MILLER

Surveyed June 13 1962, by *L.W. Johnson*