


T. IS. R. 4 W. W. M.

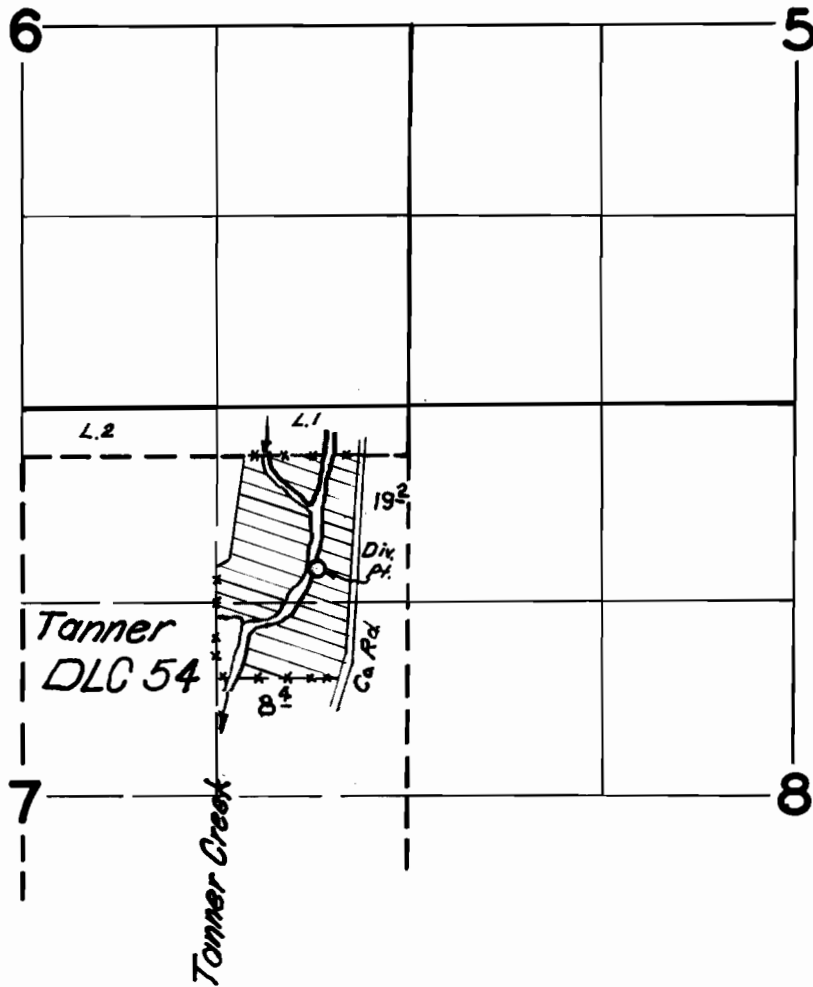

**FINAL PROOF SURVEY**  
UNDER

Application No. 30774 Permit No. 24235  
IN NAME OF

Glen A. Williams

Surveyed 15 May 1962, by Carl R. Baker