


T. 1 S. R. 2 W. W. M.

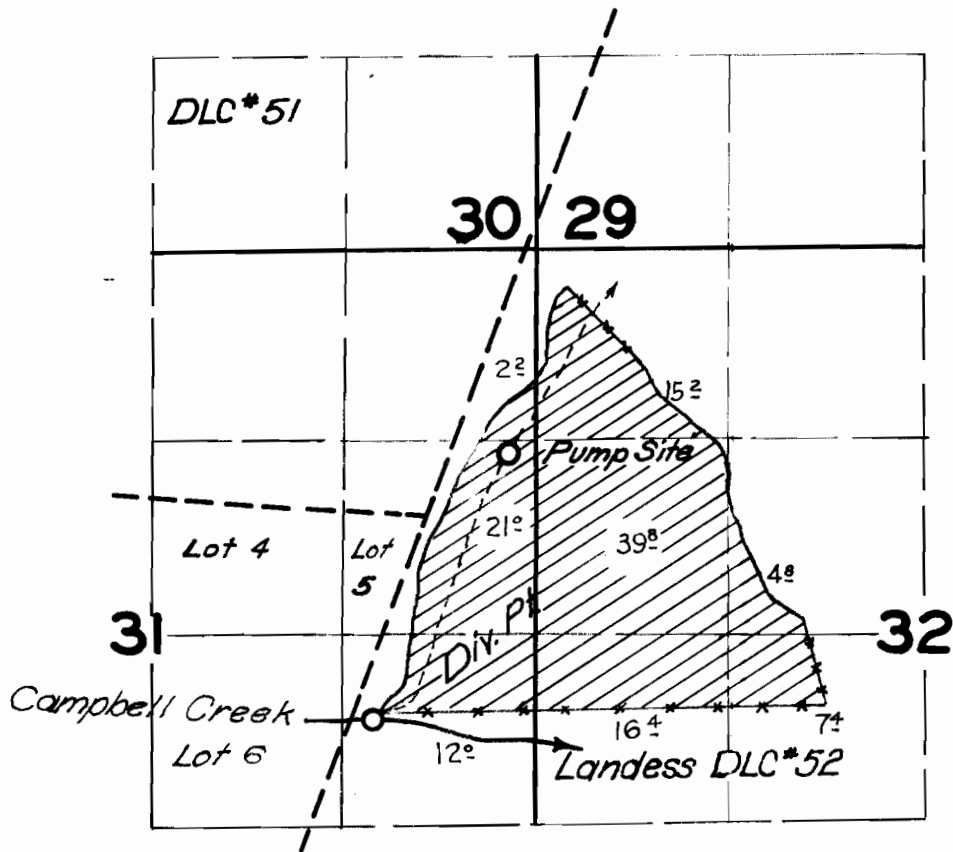

FINAL PROOF SURVEY UNDER

Application No. *31659* Permit No. *25027*
IN NAME OF

Wilford J. Kalsch

Surveyed *1 June* 1962, by *Carl R. Baker*