


T.I.S. R. 3 W.W.M.

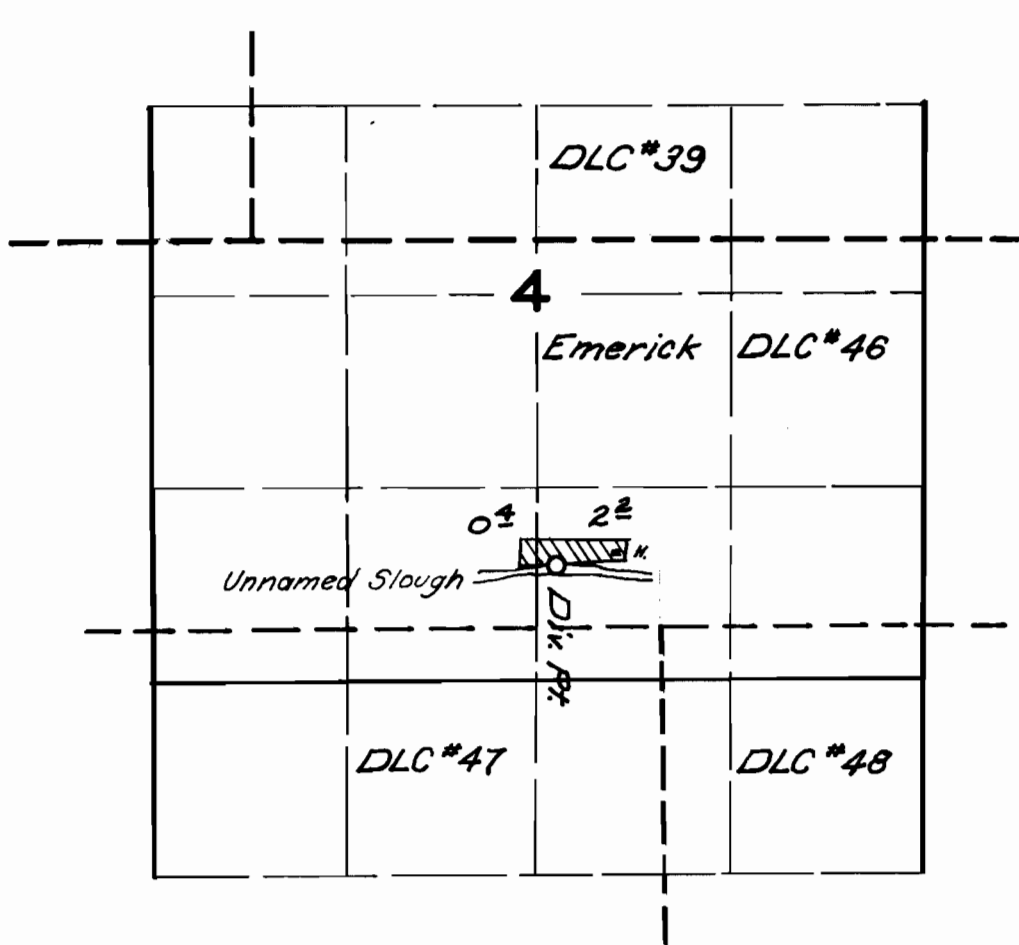

FINAL PROOF SURVEY UNDER

Application No. *32501* Permit No. *25768*
IN NAME OF

L.A. Griffin

Surveyed *25 Oct.* 1962, by *Carl R. Baker*