


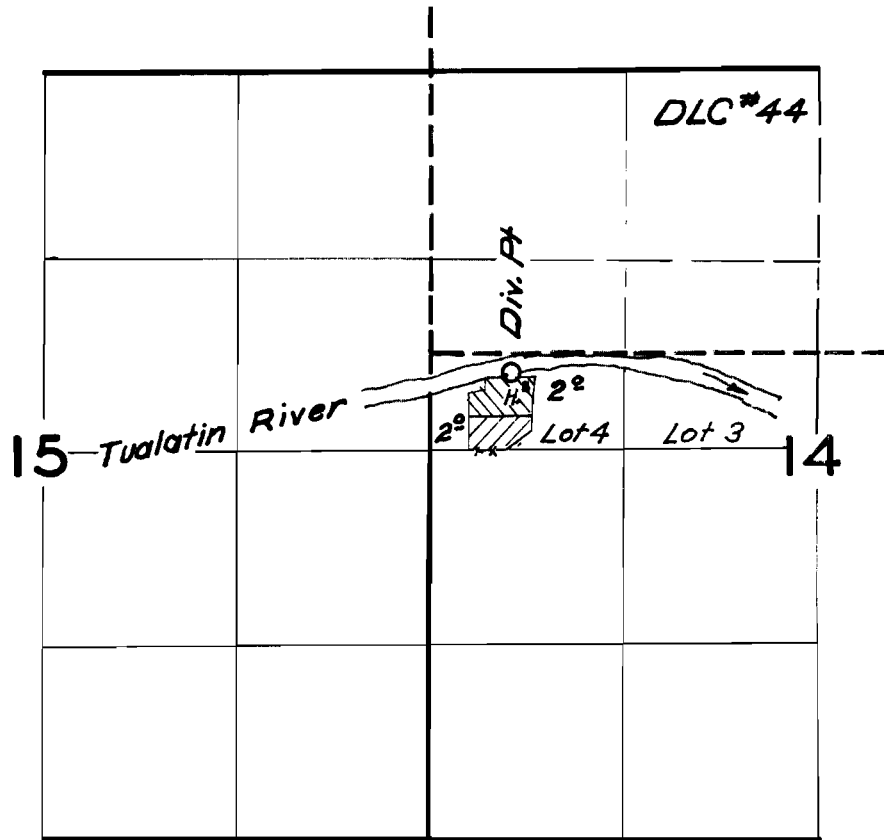

T.2S.R.I.W.W.M.



-  Application # 33606
-  Application # 37127

FINAL PROOF SURVEY UNDER

Application No. ~~37127~~ **33606** Permit No. ~~27662~~ **26572**
IN NAME OF

Vincent M. Rife

Surveyed *25 Oct.* 1962, by *Carl R. Baker*