


T.7S.R.46E.W.M.

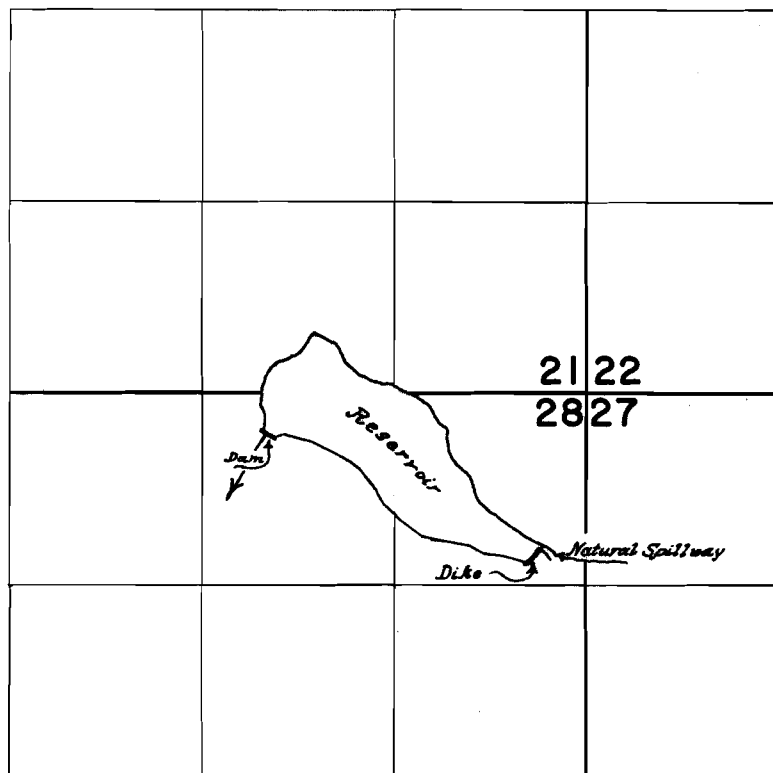

FINAL PROOF SURVEY
UNDER

Application No. *R-21312* Permit No. *R-923*
IN NAME OF

J. Roscoe & Myrtle E. Lee

Surveyed *Sept. 19*, 1960, by *M. Bish*