


T.7S. R.46E.W.M.

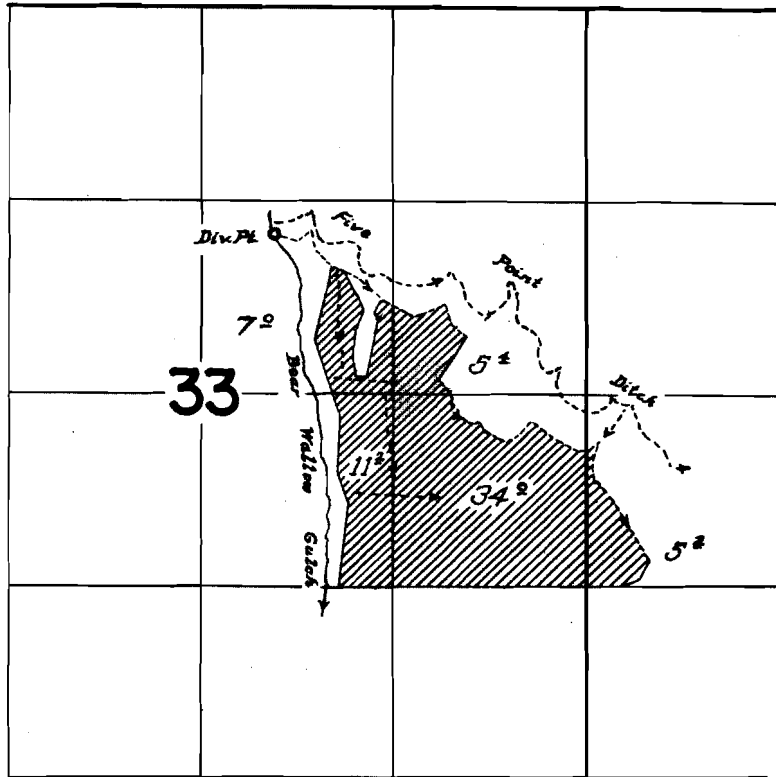

FINAL PROOF SURVEY UNDER

Application No. *21320* Permit No. *18112*
IN NAME OF

J. Roscoe + Myrtle E. Lee

Surveyed *August 23 1962*, by *Thomas R. Lauer*