


T.10S. R.38&4 W. W.M

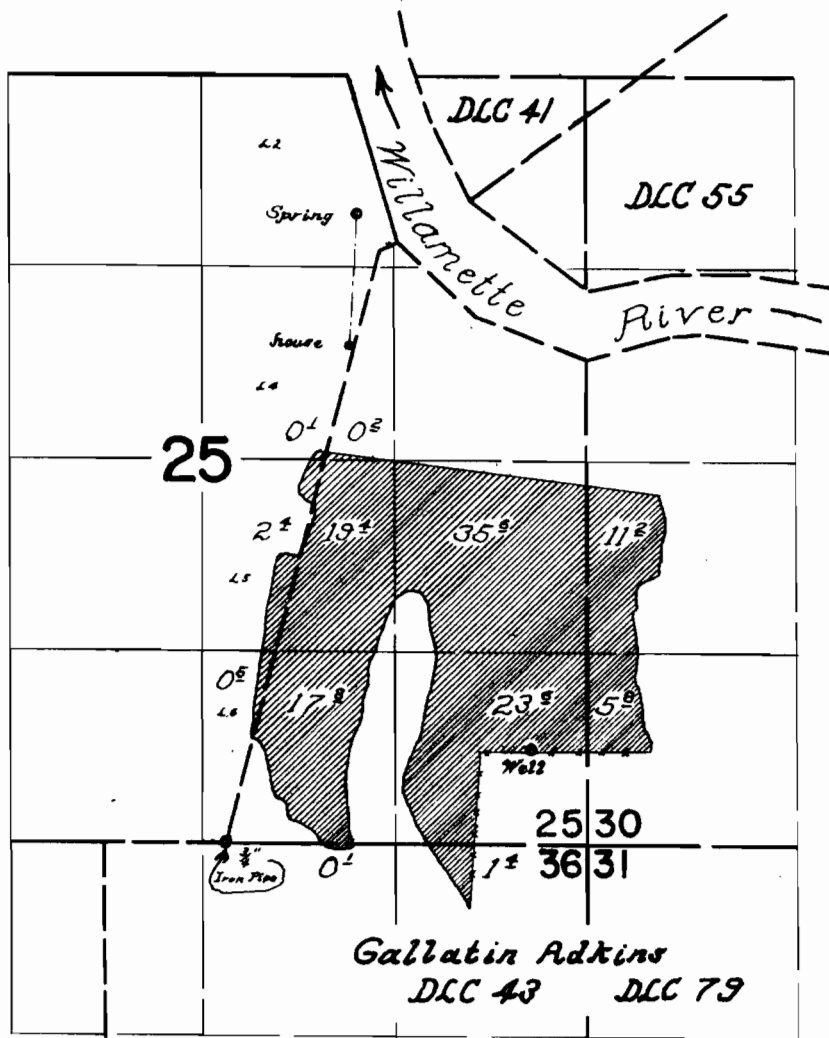

FINAL PROOF SURVEY UNDER

Application No. ³²⁹¹¹ G-1780 Permit No. ²⁵⁹⁸¹ G-1250
IN NAME OF

North Albany Land Co. Inc.

Surveyed October 25 1962, by Thomas R. Lauer.