


T.3S.R.5E.W.M.

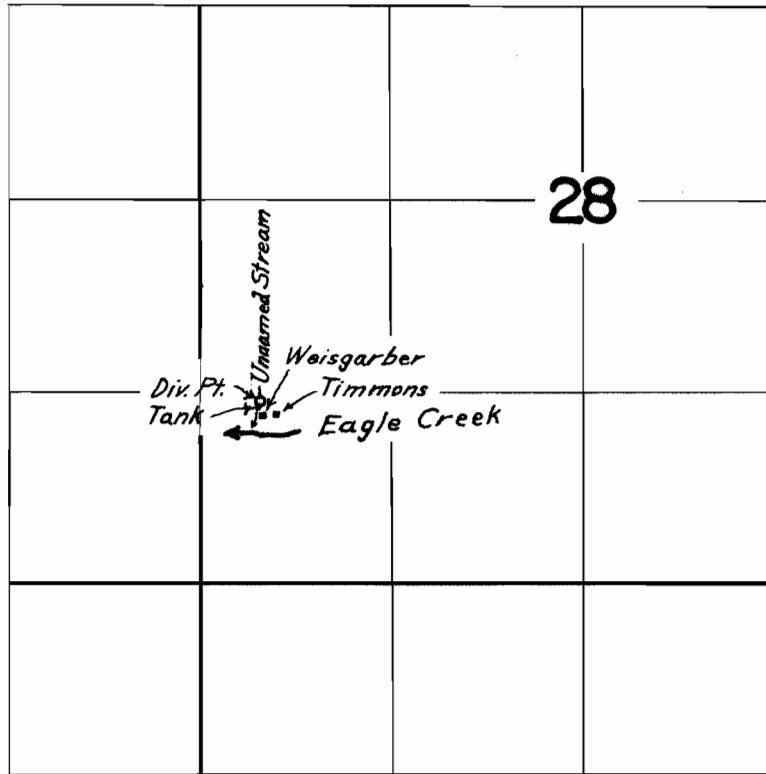

FINAL PROOF SURVEY UNDER

Application No. 37111 Permit No. 27659
IN NAME OF

Robert Hess Weisgarber

Surveyed June 26 1962, by Thomas B. Lauer