


T.6N.R.3W.W.M

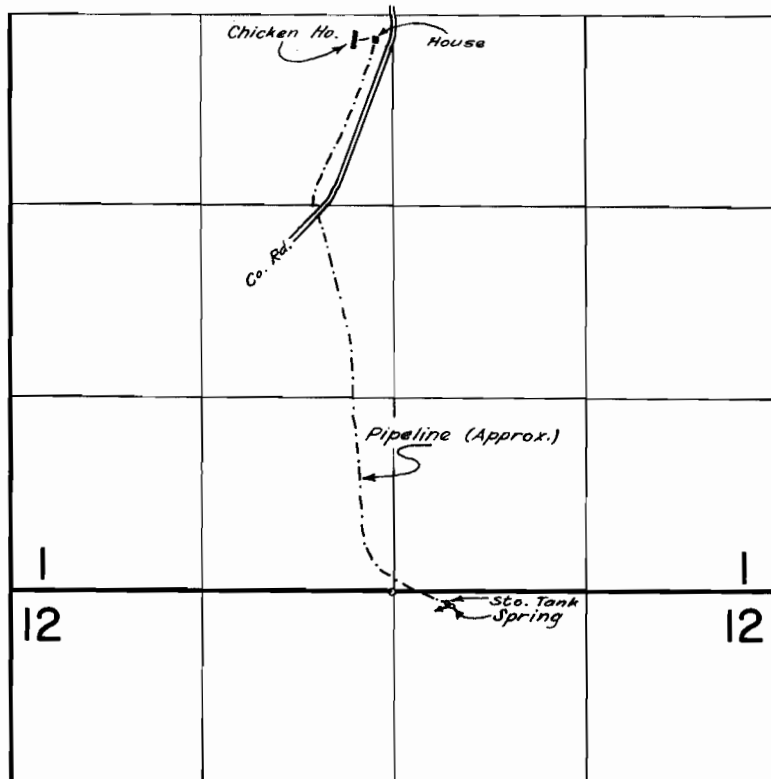

FINAL PROOF SURVEY
UNDER

Application No. **34582** Permit No. **27158**
IN NAME OF

JAMES HOARD

Surveyed July 17, 1962, by

[Signature]