


T.14S. R.16E.W.M.

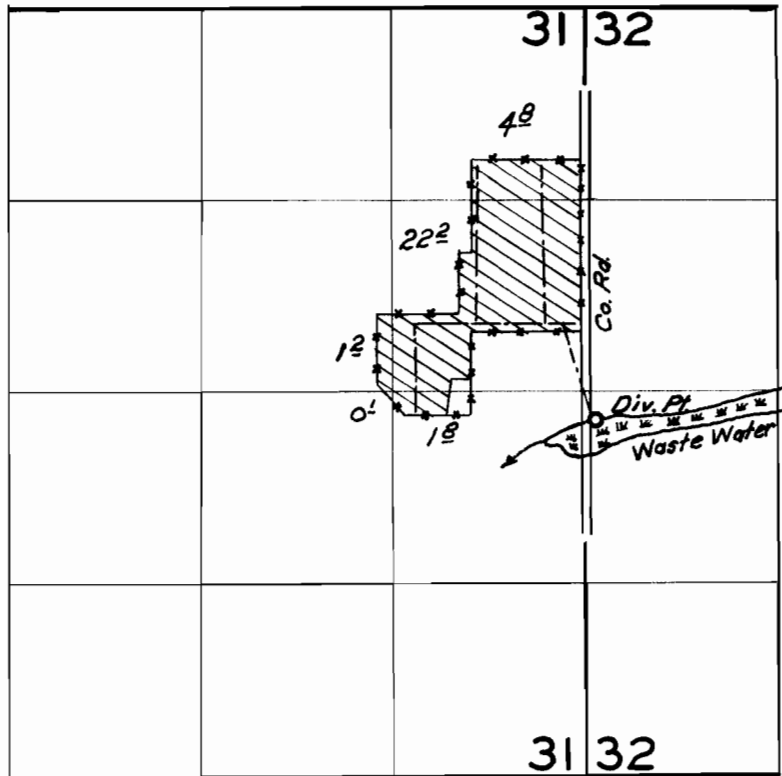

FINAL PROOF SURVEY
UNDER

Application No. 30570... Permit No. 24083...
IN NAME OF

Crook County Cemetery District

Surveyed 29 Oct. 1962., by Carl R. Baker...