


T. 15 S. R. 10 E.W.M.

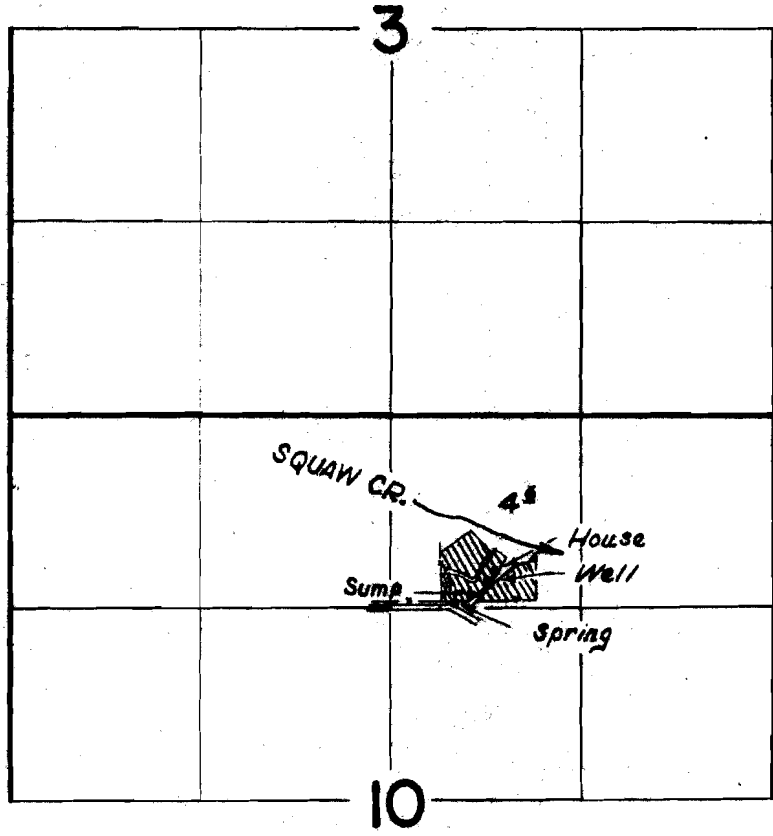

FINAL PROOF SURVEY UNDER

Application No. ^{G-1718} 33877 Permit No. ^{G-1575} 26701
 IN NAME OF

CHARLES H. FARRER

Surveyed Oct. 29, 1962, by R.H. Jackson.

g-1575
1962-0