


T. 28 S. R. 7 W. W.M.

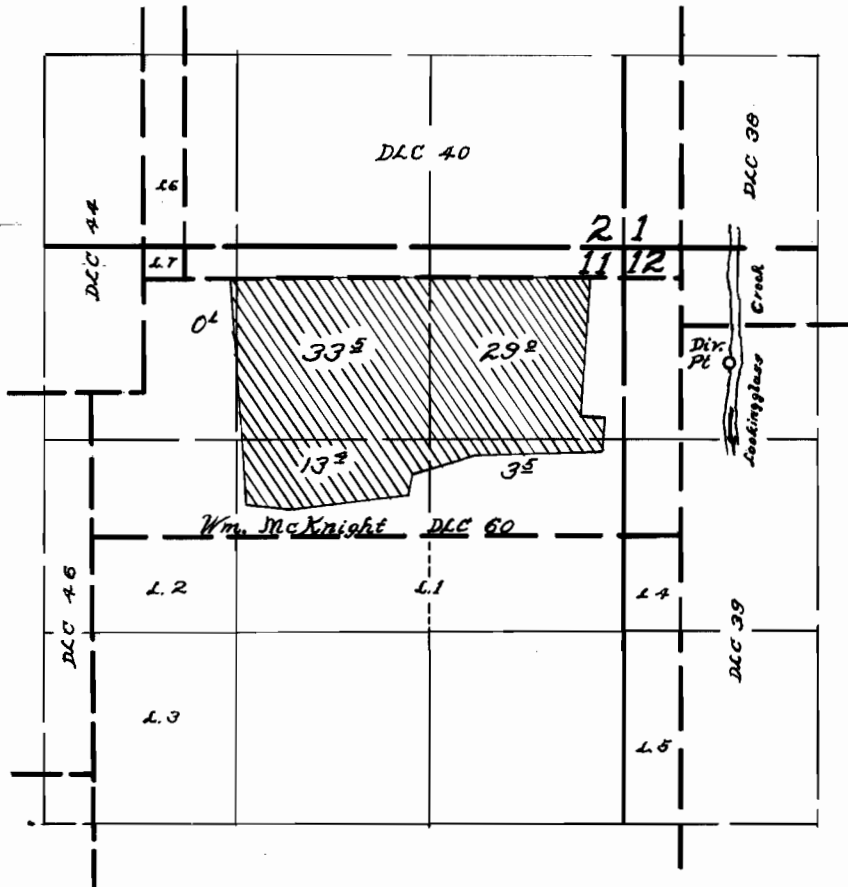

**FINAL PROOF SURVEY**  
UNDER

Application No. 32810 Permit No. 25901  
IN NAME OF

E. E. Ollivant

Surveyed July 31 1962, by Carl Baker