


T.29S.R.7W.W.M.

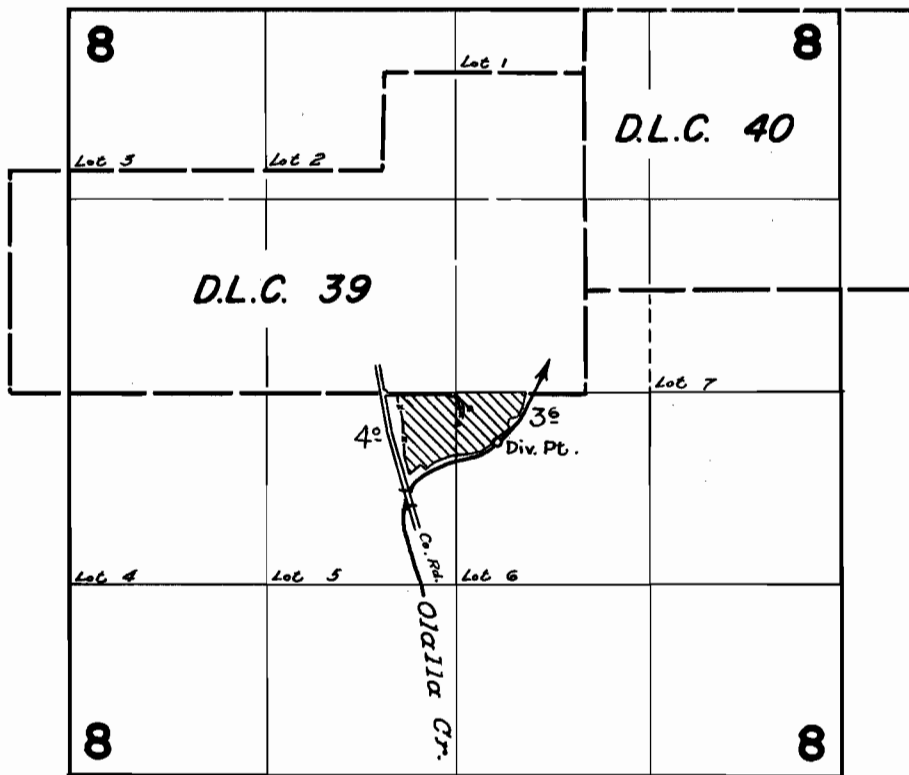

FINAL PROOF SURVEY UNDER

Application No. 32882... Permit No. 25967...
IN NAME OF

ARTHUR W. & PHEBE MCGUIRE
LLOYD J. & GERTRUDE C. BROADSWORD

Surveyed August 7, 1962, by *[Signature]*