


T.27S.R.6W.W.M.

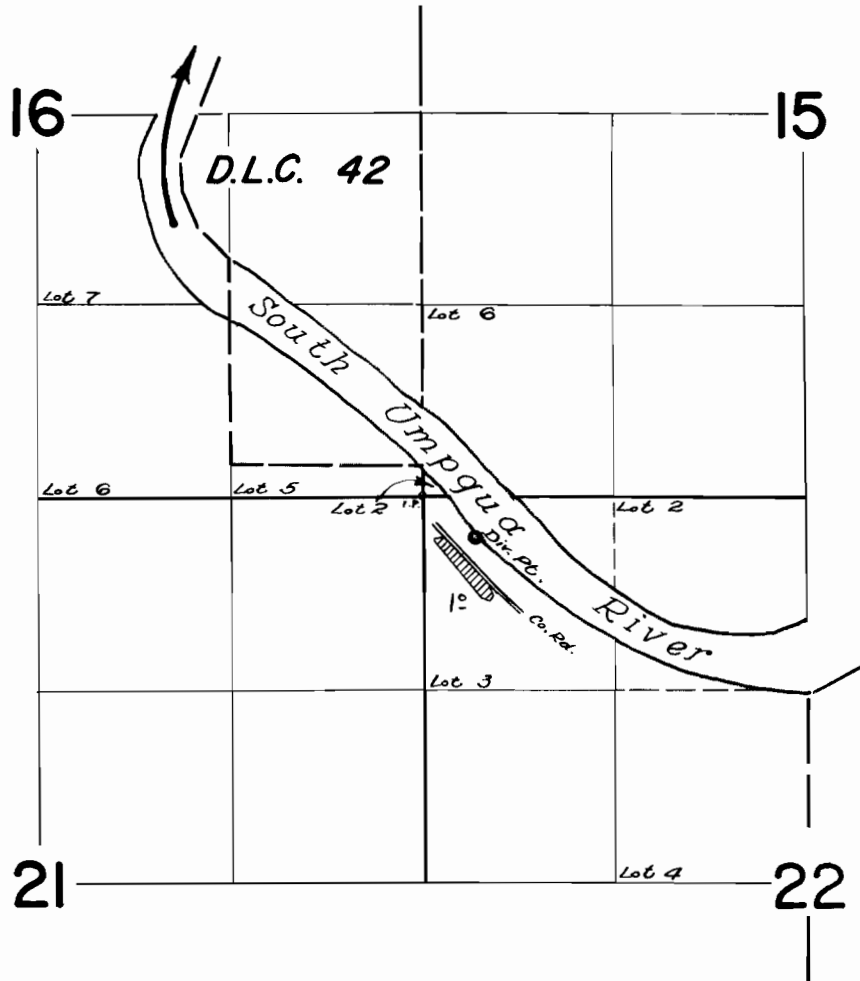

FINAL PROOF SURVEY
UNDER

Application No. 33191..... Permit No. 26249.....
IN NAME OF

JAMES B. KILKENNY

Surveyed August 10 1962, by *A. Jackson*