


T.25S.R.5 W.W.M.

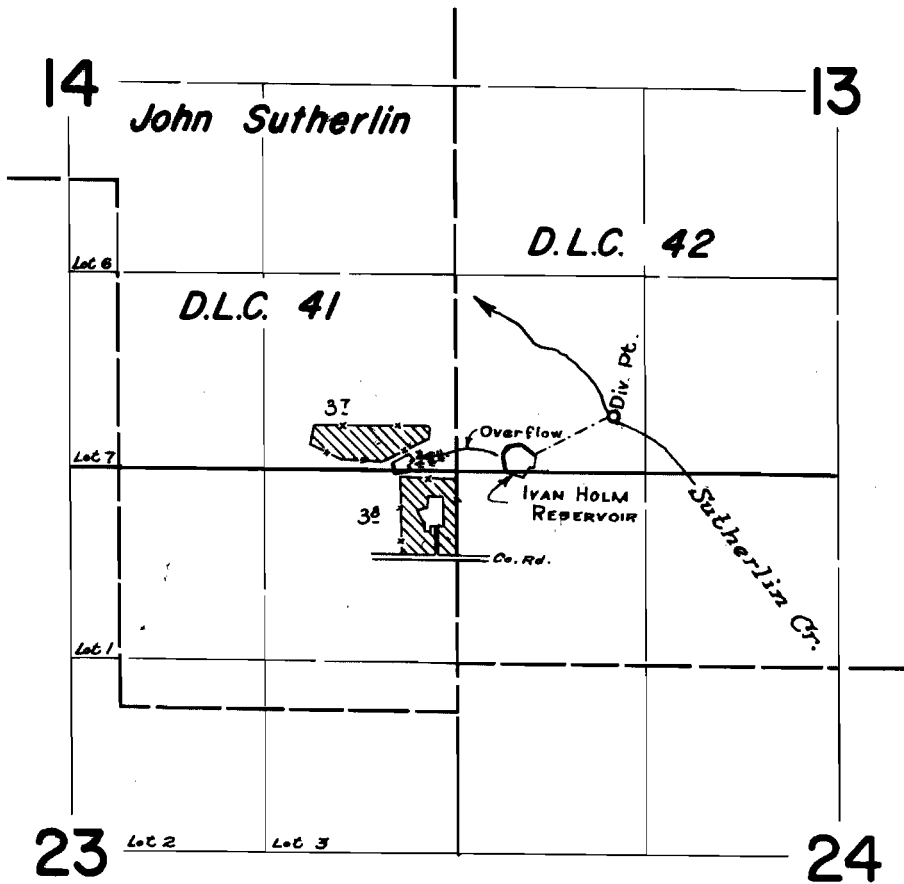

FINAL PROOF SURVEY UNDER

Application No. 33419 Permit No. 26450
IN NAME OF

ELIJAH R. & SARAH HOLM

Surveyed August 8, 1962, by

[Handwritten Signature]