


T.25S.R.5W.W.M.

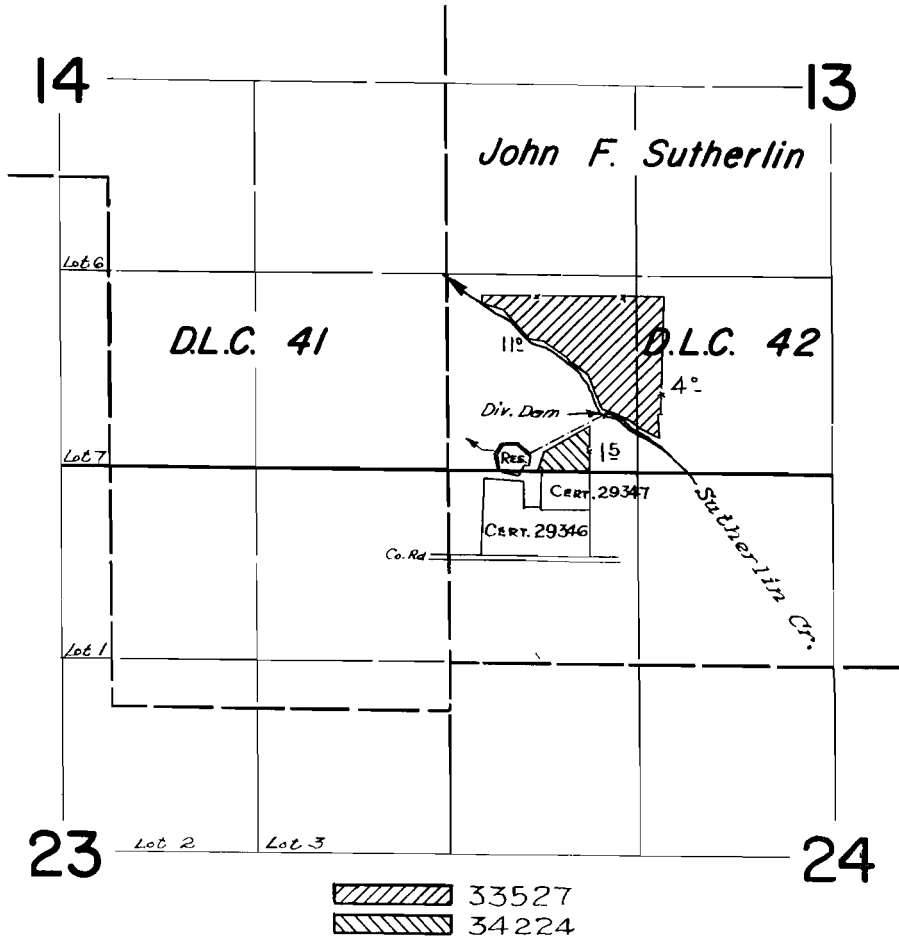

FINAL PROOF SURVEY UNDER

33527 26516
Application No. 34224... Permit No. 26955...
IN NAME OF

IVAN E. HOLM

Surveyed August 8, 1962, by *R. Jackson*