


# T.25S.R.5W.W.M.

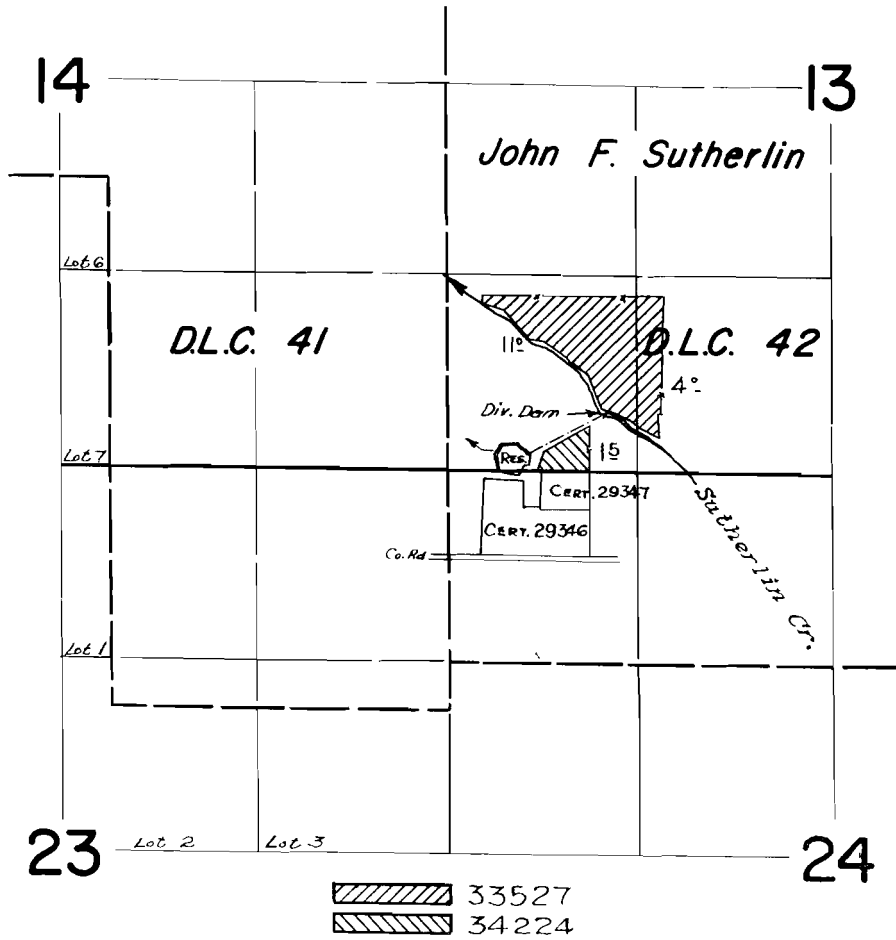

## FINAL PROOF SURVEY UNDER

33527                      26516  
Application No. 34224    Permit No. 26955  
IN NAME OF

IVAN E. HOLM

Surveyed August 8, 1962, by *R. Jackson*