


T.29S.R.7W.W.M.

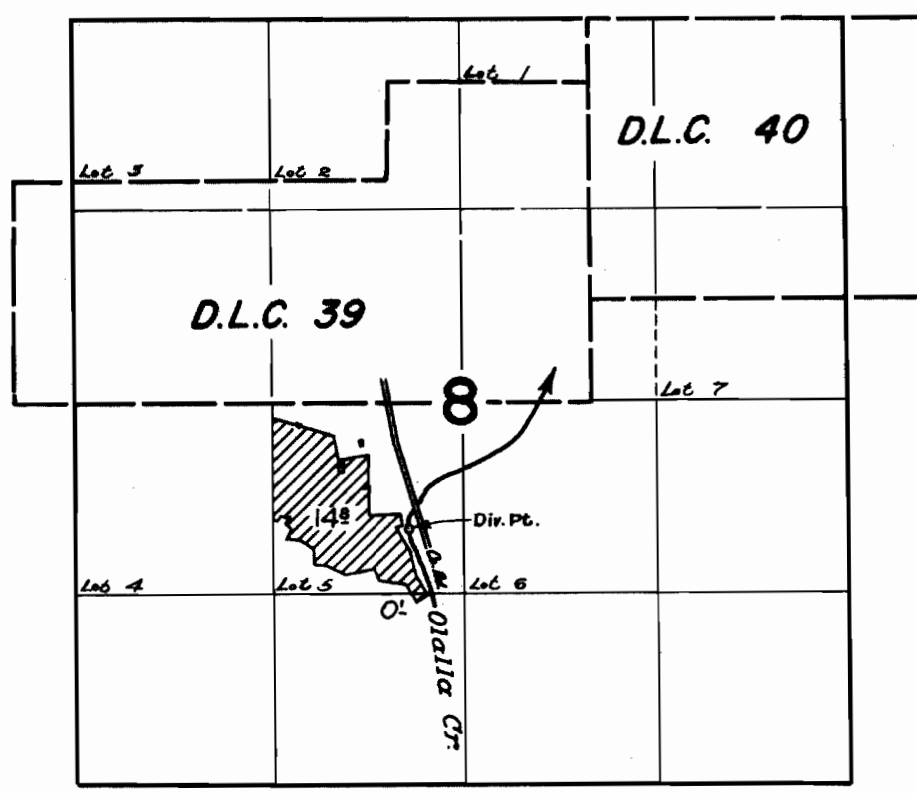

FINAL PROOF SURVEY UNDER

Application No. 34591... Permit No. 27157.....
IN NAME OF

KEITH & EVELYN HUSEN

Surveyed August 7, 1962, by *[Signature]*