


T.4S. R.20 & 21E.W.M.

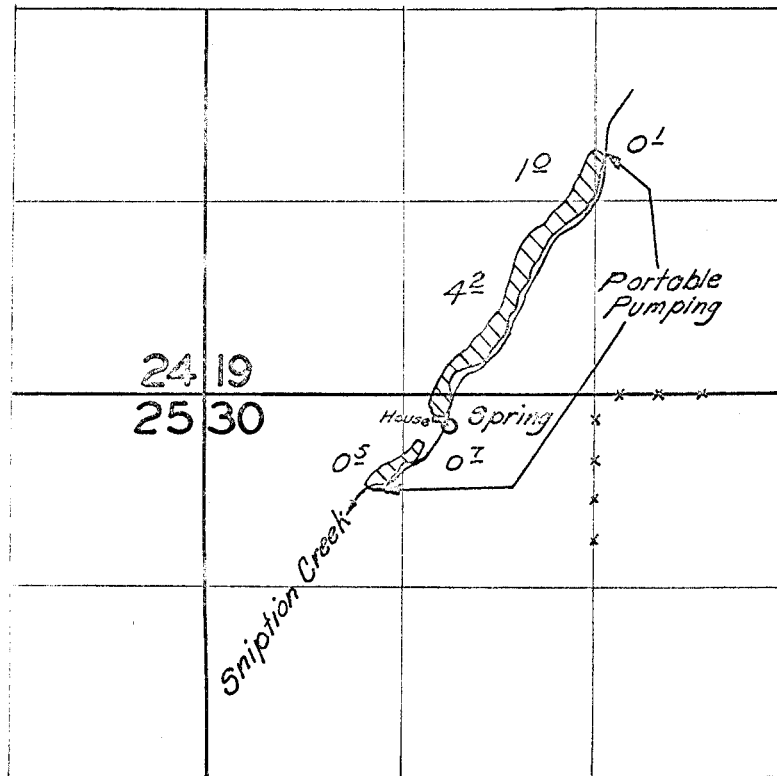

FINAL PROOF SURVEY UNDER

Application No. 28306 Permit No. 22255
IN NAME OF

S.M. & Grace D. Cooney

Surveyed Oct. 3, 1962, by Carl R. Baker