


G-1546
31046

T. 13 S. R. 30 E. W.M.

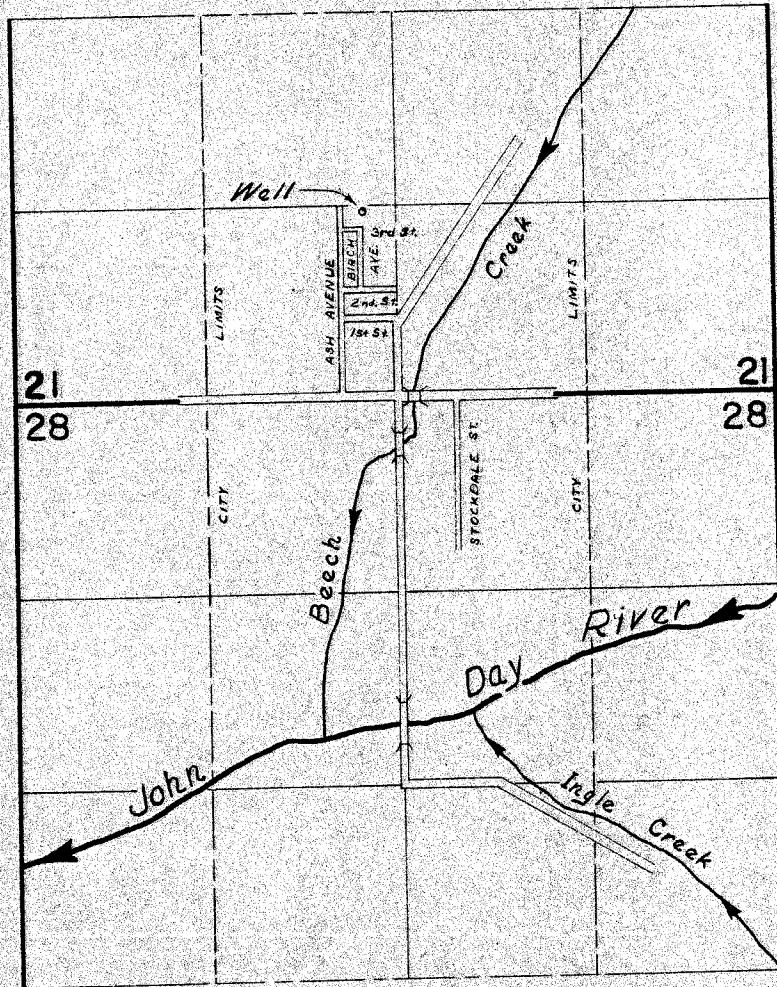

FINAL PROOF SURVEY UNDER

Application No. G-1640. Permit No. G-1546
IN NAME OF

CITY of Mt. VERNON

Surveyed Nov 8 1962, by TR Lauer