


T.13 S. R. 33 E.W.M.

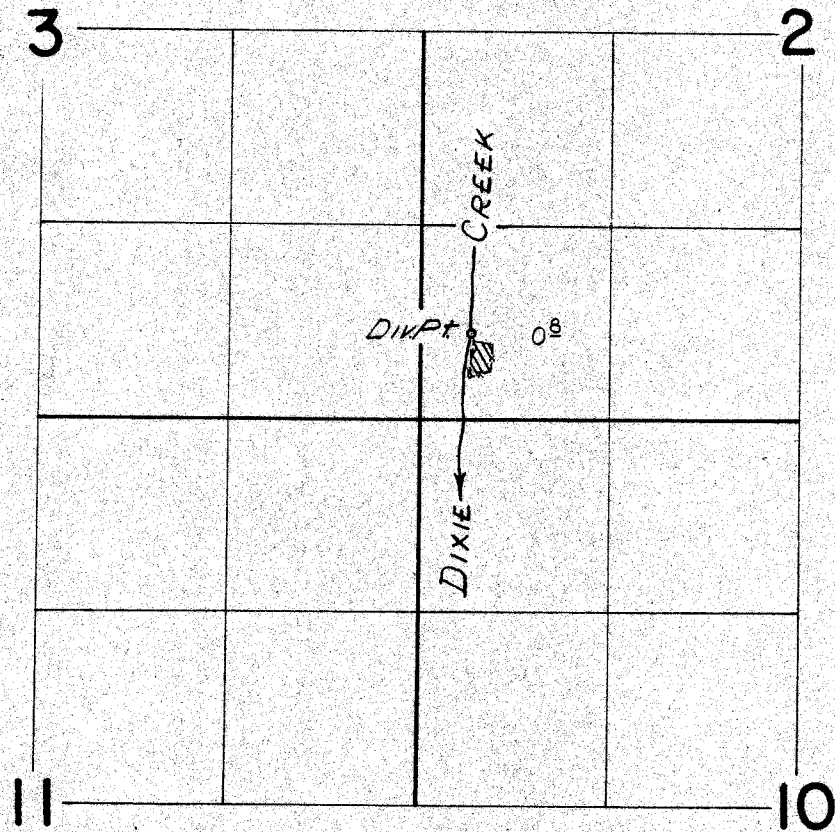

FINAL PROOF SURVEY UNDER

Application No. 30711 Permit No. 24190
IN NAME OF

GEORGE H. WALDON

Surveyed Nov. 10 1962 by C.R. Baker